

THIS IS NOT A BUILDING PERMIT

Fifth Schedule Clause 42
For Office Use Only
Serial No. 5.2014.354.1

**CITY OF VINCENT TOWN PLANNING SCHEME
APPROVAL TO COMMENCE DEVELOPMENT**

LOT: 27 D/P: 1177

STRATA LOT: N/A

PROPERTY ADDRESS: No. 39 Knebworth Avenue, PERTH

OWNER: G T Johnson
39 Knebworth Avenue
PERTH WA 6000

Approval to commence development in accordance with the application for City Planning Approval dated 19 June 2014 for Construction of Three Storey Grouped Dwelling and the attached plans dated 4 November 2014 was GRANTED in accordance with the provisions of the City of Vincent Town Planning Scheme and the Metropolitan Region Scheme subject to the following conditions:

1. Boundary Wall

The owners of the subject land shall finish and maintain the surface of the boundary (parapet) walls facing No. 37 Knebworth Avenue, Perth, in a good and clean condition. The finish of the walls is to be to the satisfaction of the City and can either be fully rendered or face brickwork;

2. Verge Trees

No street verge tree on Knebworth Avenue shall be removed. The street verge tree is to be retained and protected from any damage including unauthorised pruning;

3. Building Appearance

All external fixtures shall be designed integrally with the development and shall not be visually obtrusive from Knebworth Avenue and neighbouring properties. External fixtures are such things as television antennas (of a non-standard type), radio and other antennas, satellite dishes, external hot water heaters, air conditioners and the like;

4. Storm Water

All storm water produced on the subject land shall be retained on site, by suitable means to the full satisfaction of the City; and

5. PRIOR TO THE SUBMISSION OF A BUILDING PERMIT APPLICATION, the following shall be submitted to and approved by the City:

- 5.1 Privacy Screening

Revised Plans showing that the major openings to the Kitchen and Lounge (upper floor) and Deck (Upper floor) at any point within the cone of vision less than 4.5 metres and 7.5 metres respectively from a neighbouring boundary, shall be screened in accordance with the requirements of the Residential Design Codes November 2013 to the satisfaction of the City; and

- 5.2 The first floor boundary wall of the bathroom being reduced to a maximum length of 4.32 metres.

ADVICE NOTES:

1. With regard to condition 1, the owners of the subject land shall obtain the consent of the owners of the relevant adjoining properties before entering those properties in order to make good the boundary walls;
2. A Road and Verge security bond for the sum of \$2000, shall be lodged with the City by the applicant, prior to the issue of a building permit, and will be held until all building/development works have been completed and any disturbance of, or damage to the City's infrastructure, including verge trees, has been repaired/reinstated to the satisfaction of the City. An application for the refund of the security bond shall be made in writing. The bond is non-transferable;
3. Any new street/front wall, fence and gate within the Right of Way setback area, including along the side boundaries within these street setback areas, shall comply with the City's Policy provisions relating to Street Walls and Fences; and
4. With regard to condition 4, no further consideration shall be given to the disposal of storm water 'off-site' without the submissions of a geotechnical report from a qualified consultant. Should approval to dispose storm water 'off site' be subsequently provided, detailed design drainage plans and associated calculations for the proposed storm water disposal shall be lodged together with the building permit application working drawings.

NOTES:

PLEASE NOTE THAT ANY AMENDMENTS PROPOSED IN THE BUILDING PERMIT APPLICATION PLANS, WHICH DIFFER FROM THE PLANNING APPROVAL PLANS, MAY RESULT IN THE REQUIREMENT FOR A NEW PLANNING APPLICATION TO BE SUBMITTED FOR ASSESSMENT AND DETERMINATION. SHOULD THIS BE THE CASE, THE OWNER/BUILDER/DEVELOPER IS ADVISED TO FACTOR IN AN ADDITIONAL TIME PERIOD INTO THE DEVELOPMENT/BUILDING PROCESS.

PLEASE NOTE THAT ANY ADDITIONAL PROPERTY NUMBERING TO THE ABOVEMENTIONED ADDRESS, WHICH IS RESULTANT FROM THIS APPLICATION, IS TO BE ALLOCATED BY THE CITY OF VINCENT AND NO OTHER PARTIES. IT IS RECOMMENDED THAT YOU LIAISE WITH THE CITY'S PLANNING SECTION ON THE ABOVE MATTER, DURING THE BUILDING PERMIT ISSUE STAGE.


OWNER(S), BUILDER(S) AND DEVELOPER(S) UNDERTAKING DEVELOPMENT/CONSTRUCTION OF ANY KIND ARE HEREBY ADVISED OF A RESPONSIBILITY TO COMPLY WITH THE REQUIREMENTS OF THE DISABILITY DISCRIMINATION ACT 1992. FOR FURTHER INFORMATION ON THIS ACT, ENQUIRIES SHOULD BE DIRECTED TO THE DISABILITY SERVICES COMMISSION ON TELEPHONE NUMBER (08) 9426 9200 OR TTY ON (08) 9426 2325.

SHOULD THE APPLICANT BE AGGRIEVED BY THE DECISION A RIGHT OF APPEAL MAY EXIST UNDER THE PROVISIONS OF THE TOWN PLANNING SCHEME OR THE METROPOLITAN REGION SCHEME.

This approval is valid for a period of TWO years only. If the development is not substantially commenced within this period, a fresh approval must be obtained before commencing or continuing the development.


DATE OF DECISION: 10 February 2015
DATE OF ISSUE: 19 February 2015

A Groom
for **MANAGER**
PLANNING AND BUILDING SERVICES

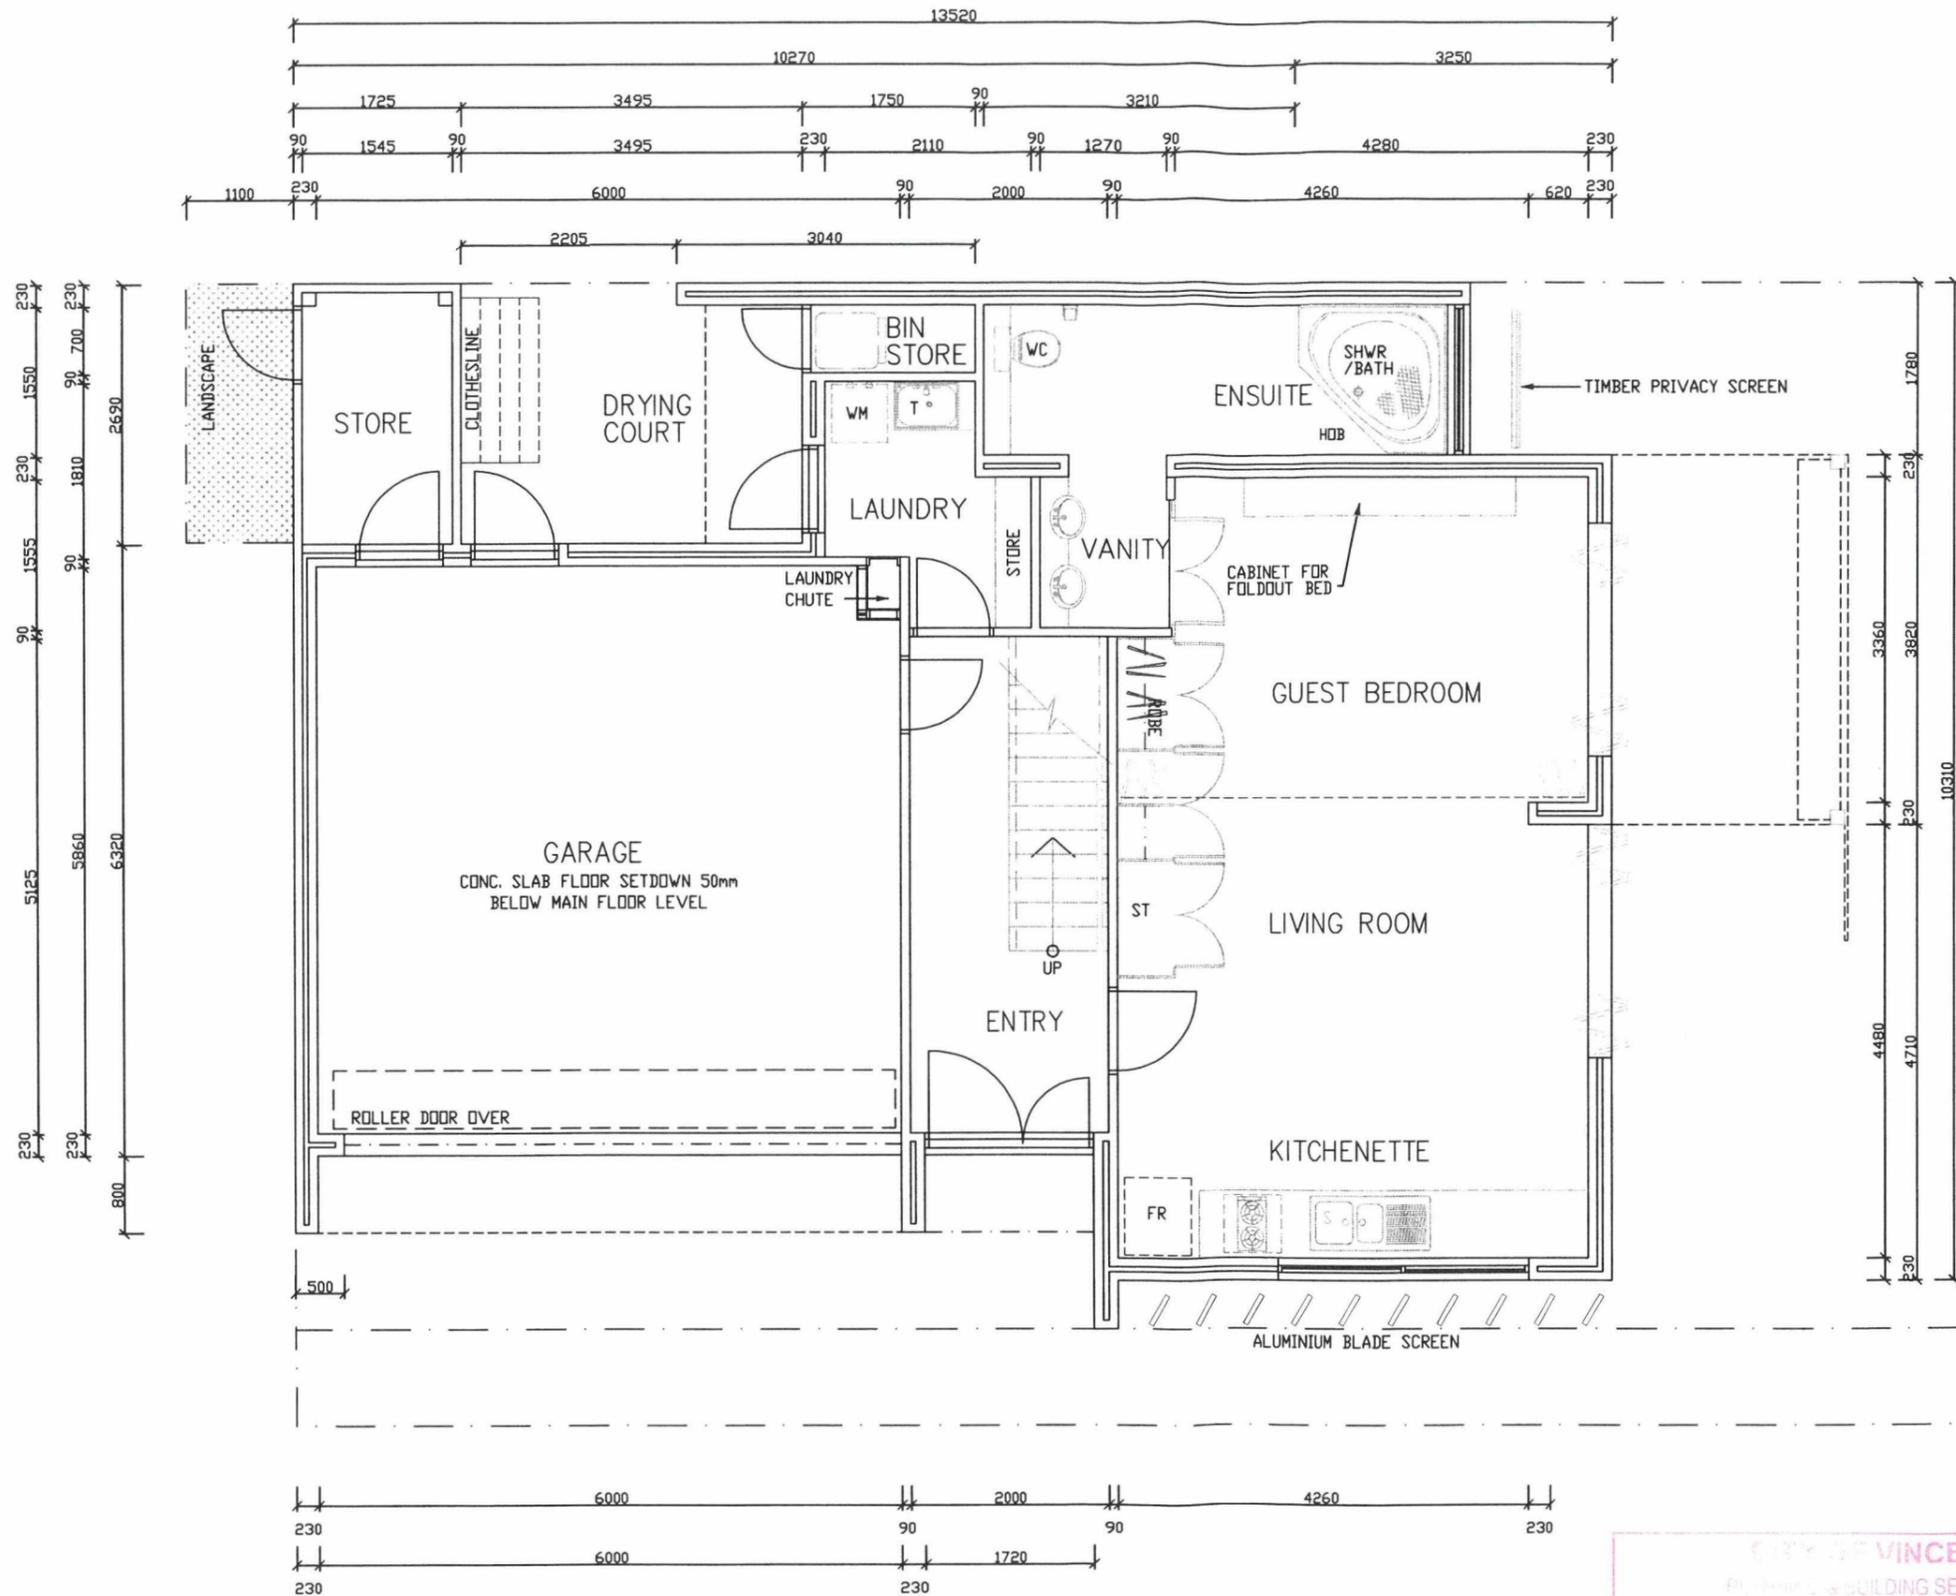

NOTES :
 1. ONLY USE FIGURED DIMENSIONS
 DO NOT SCALE FROM DRAWINGS

28/0/14	0	FOR DEVELOPMENT APPROVAL	
date	no	revision history	check

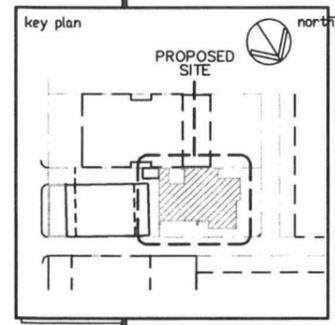

project/client

PROPOSED RESIDENCE
 FOR
 GRANT JOHNSON
 AT
 REAR, No.39 (LOT27)
 KNEBWORTH AVENUE
 NORTHBRIDGE



architects

CCN Cameron
 Chisholm &
 Nicol

Architects/interiors
 Urban Design/Master Planning
 Level 1
 306 Murray Street, Perth
 Western Australia 6000
 Postal P.O. Box F300
 ACN 053 861 948
 ABN 81 053 861 948

Telephone (08) 9322 1566
 Facsimile (08) 9481 0854
 Email perth@ccnarchitects.com.au
 Website www.ccnarchitects.com.au

CITY OF VINCENT
 PLANNING & BUILDING SERVICES

APPROVED IN ACCORDANCE WITH
 FORM M.P.S.2 (REVISED) AND AMENDMENTS 5 & 6
 19/02/15
 10 FEB 2015

A.Groom for Planning & Building Services

drawing title

GROUND FLOOR PLAN


© Copyright Cameron Chisholm & Nicol (WA) Pty Ltd
 scale 1:50 (A2)

approved	date drawn JUNE 2002
proj no P0171	plot date 13-06-02
discipline status	dwg type floor
A	BLE - 01 0



NOTES :
1. ONLY USE FIGURED DIMENSIONS
DO NOT SCALE FROM DRAWINGS


28/0/14	0	FOR DEVELOPMENT APPROVAL	
date	no	revision history	check

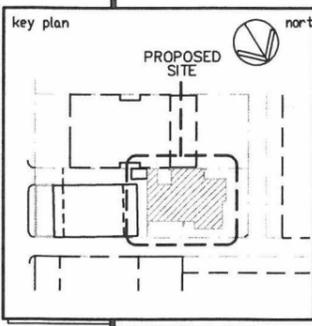


project/client
PROPOSED RESIDENCE
FOR
GRANT JOHNSON
AT
REAR, No.39 (LOT27)
KNEBWORTH AVENUE
NORTHBRIDGE

architects
CCN Cameron Chisholm & Nicol
Architecture Interiors
Urban Design Master Planning
Level 1
306 Murray Street, Perth
Western Australia 6000
(Postal P.O. Box F300)
ACN 053 861 948
ABN 81 053 861 948
Telephone (08) 9322 1566
Facsimile (08) 9481 0854
Email perth@ccnarchitects.com.au
Website www.ccnarchitects.com.au

drawing title			
FIRST FLOOR PLAN			
© Copyright Cameron Chisholm & Nicol (WA) Pty Ltd			
scale 1:50 (A2)			
approved	date drawn JUNE 2002		
proj no P0171	plot date 13-06-02		
discipline status	dwg type	floor	dwg no. rev no
A	BLE	-	020


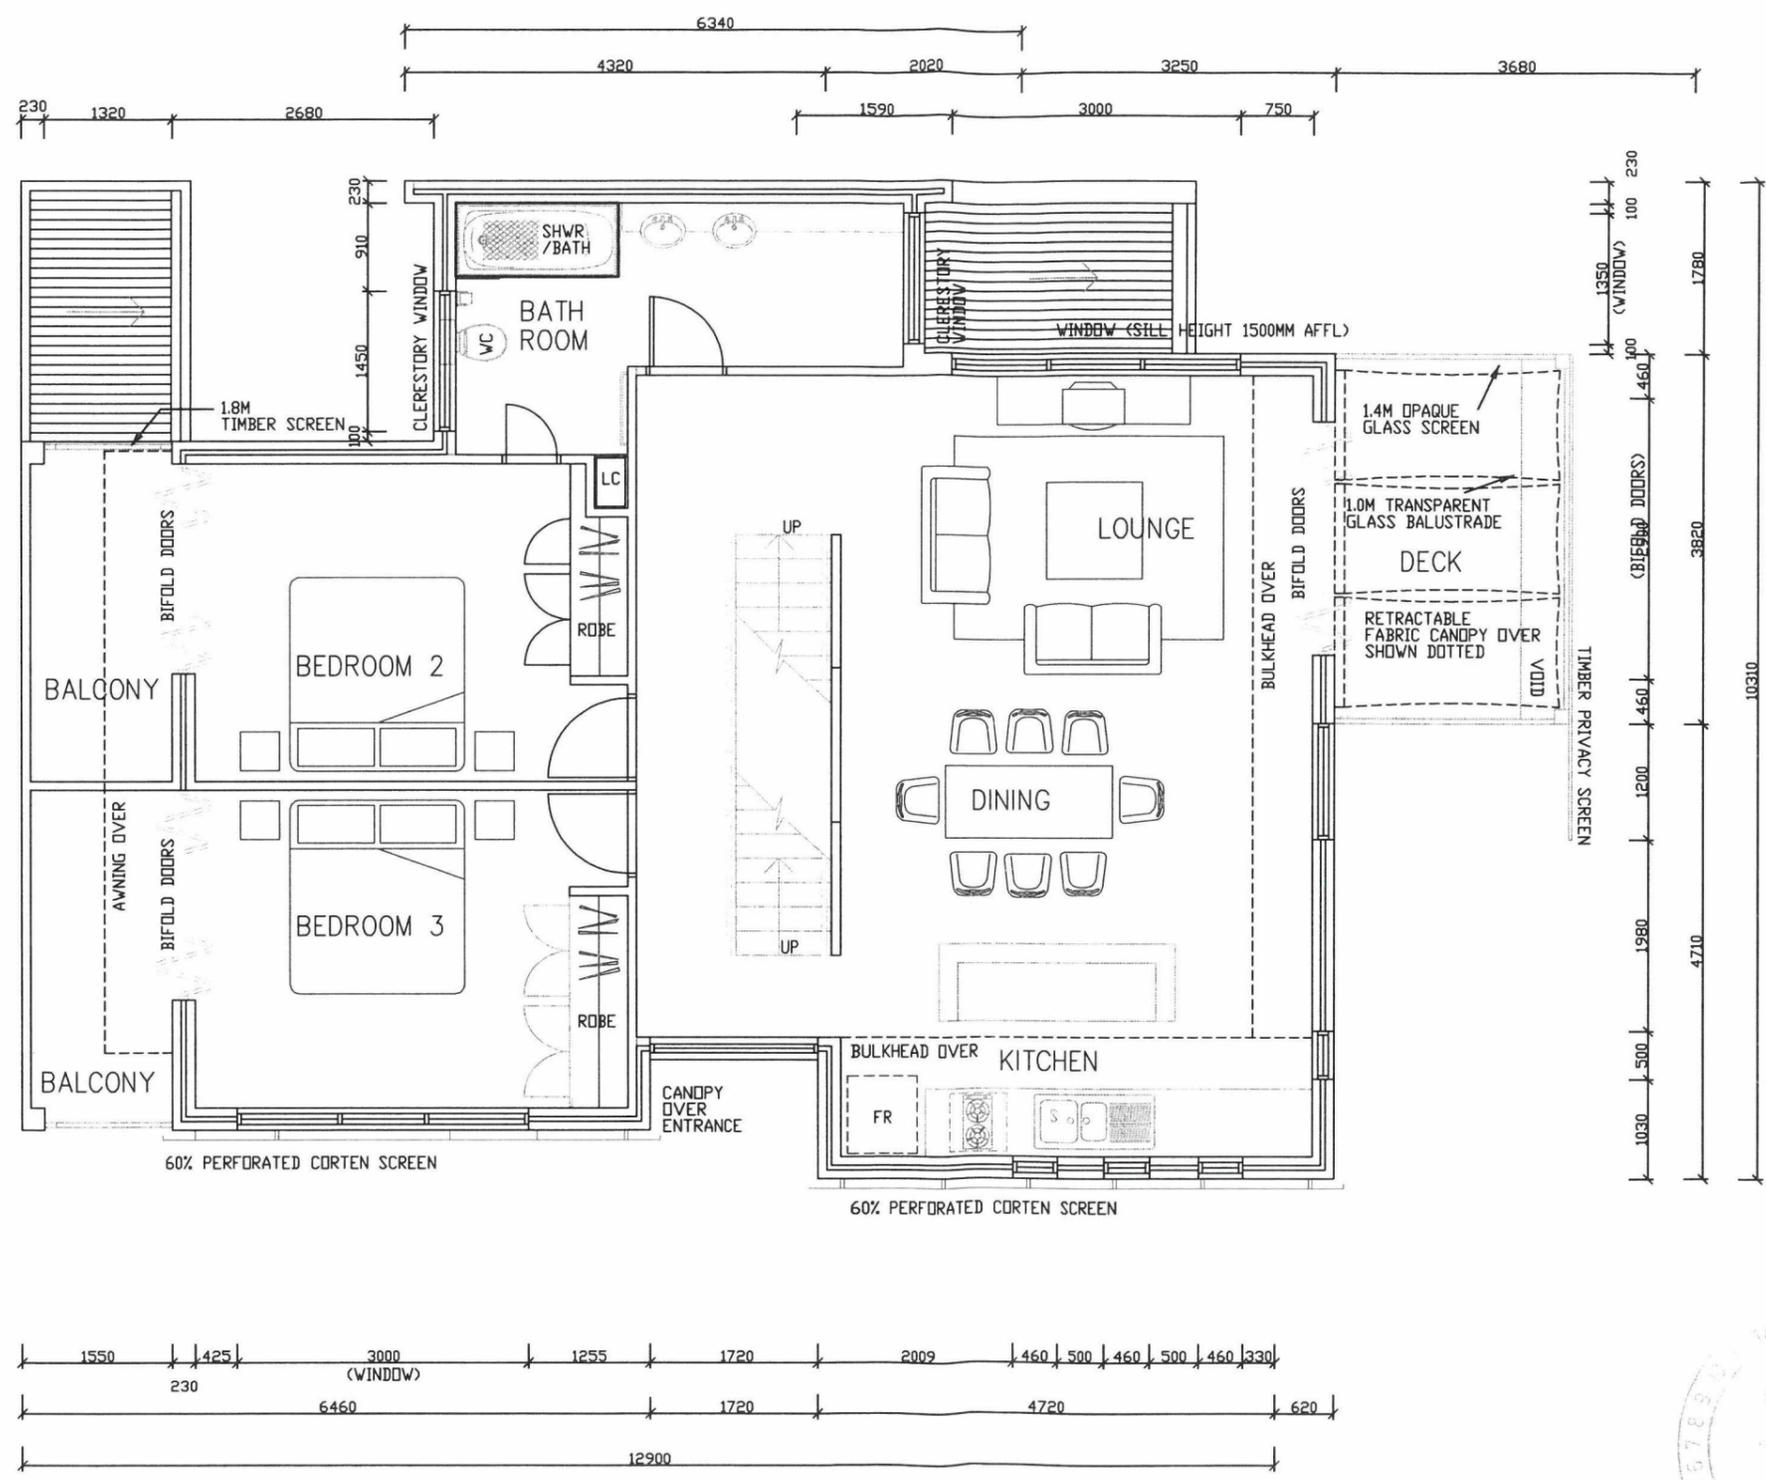


CITY OF VINCENT
PLANNING & BUILDING SERVICES
APPROVED/REFUSED
IN ACCORDANCE WITH
FORM M.R.S.2 ISSUED 19/02/15
AND AMENDMENTS SHOWN IN RED
aGroom for Manager, Planning & Building Services

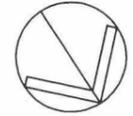

NOTES :
 1. ONLY USE FIGURED DIMENSIONS
 DO NOT SCALE FROM DRAWINGS

28/0/14	0	FOR DEVELOPMENT APPROVAL	
date	no	revision history	check

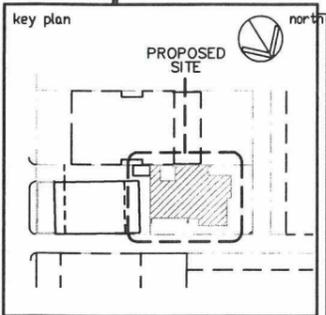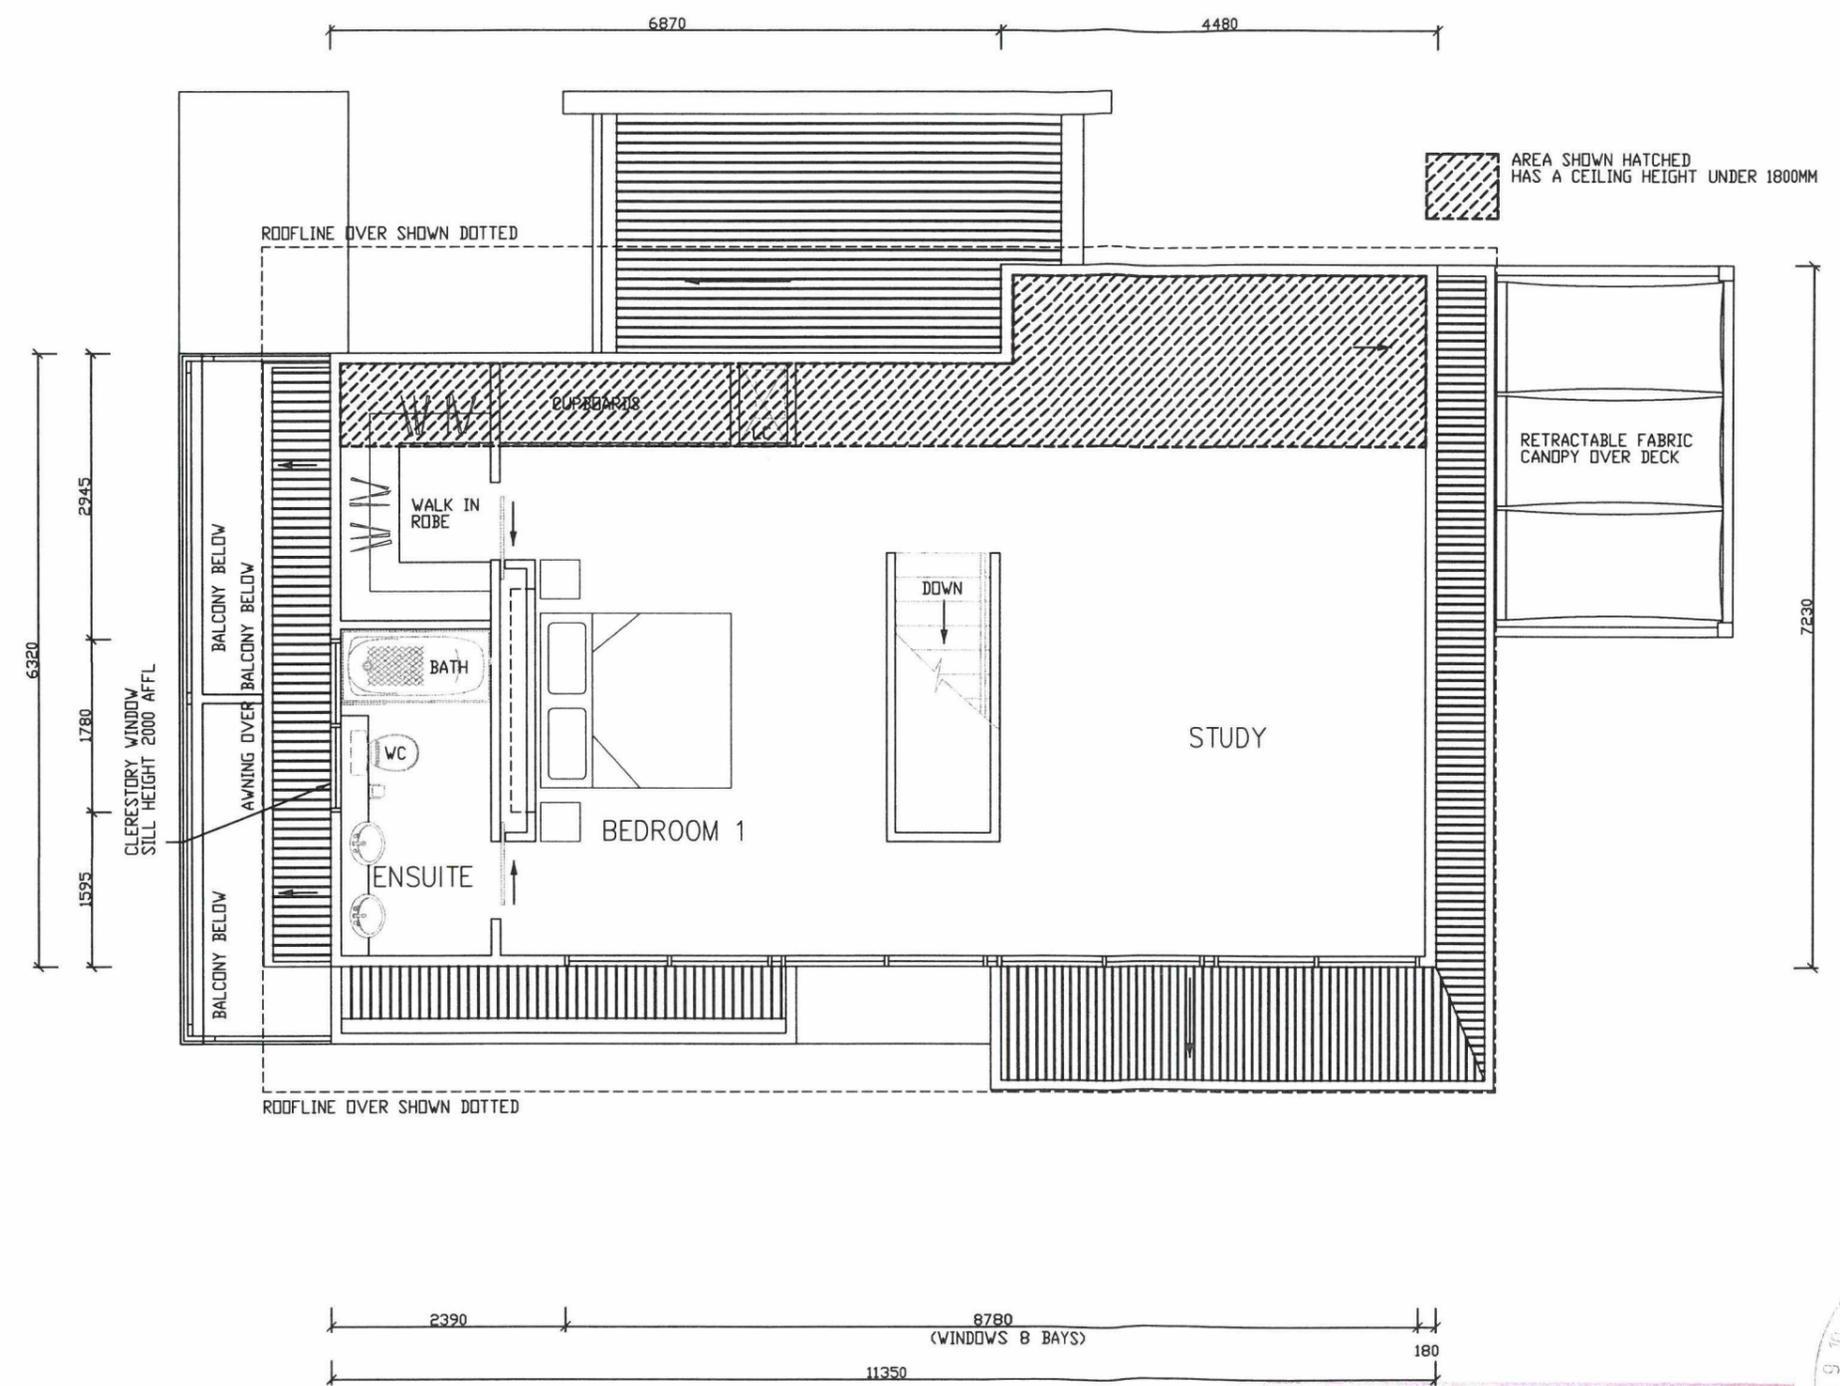

project/client

PROPOSED RESIDENCE
 FOR
 GRANT JOHNSON
 AT
 REAR, No.39 (LOT27)
 KNEBWORTH AVENUE
 NORTHBRIDGE

architects

CCN Cameron Chisholm & Nicol

Architectural Interiors
 Urban Design Master Planning
 Level 1
 306 Murray Street, Perth
 Western Australia 6000
 (Postal P. O. Box F300)
 ACN 053 861 948
 ABN 81 053 861 948

Telephone (08) 9322 1566
 Facsimile (08) 9481 0854
 Email perth@ccnarchitects.com.au
 Website www.ccnarchitects.com.au

drawing title

LOFT PLAN

© Copyright Cameron Chisholm & Nicol (WA) Pty Ltd

scale 1:50 (A2)

approved	date drawn
proj no P0171	date drawn JUNE 2002
discipline status	plot date 13-06-02
dwg type	floor dwg no.
A BLE	- 03 0


CITY OF VINCENT
 PLANNING & BUILDING SERVICES

~~APPROVED~~ IN ACCORDANCE WITH
 FORM M.P.S.2 ISSUED 19/02/15
 AND AMENDMENTS SHOWN IN RED

1 FEB 2015



aGroom for Manager, Planning & Building Services



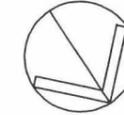

NOTES :
1. ONLY USE FIGURED DIMENSIONS
DO NOT SCALE FROM DRAWINGS

28/0/14	0	FOR DEVELOPMENT APPROVAL	
date	no	revision history	check

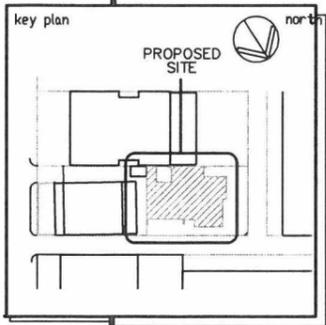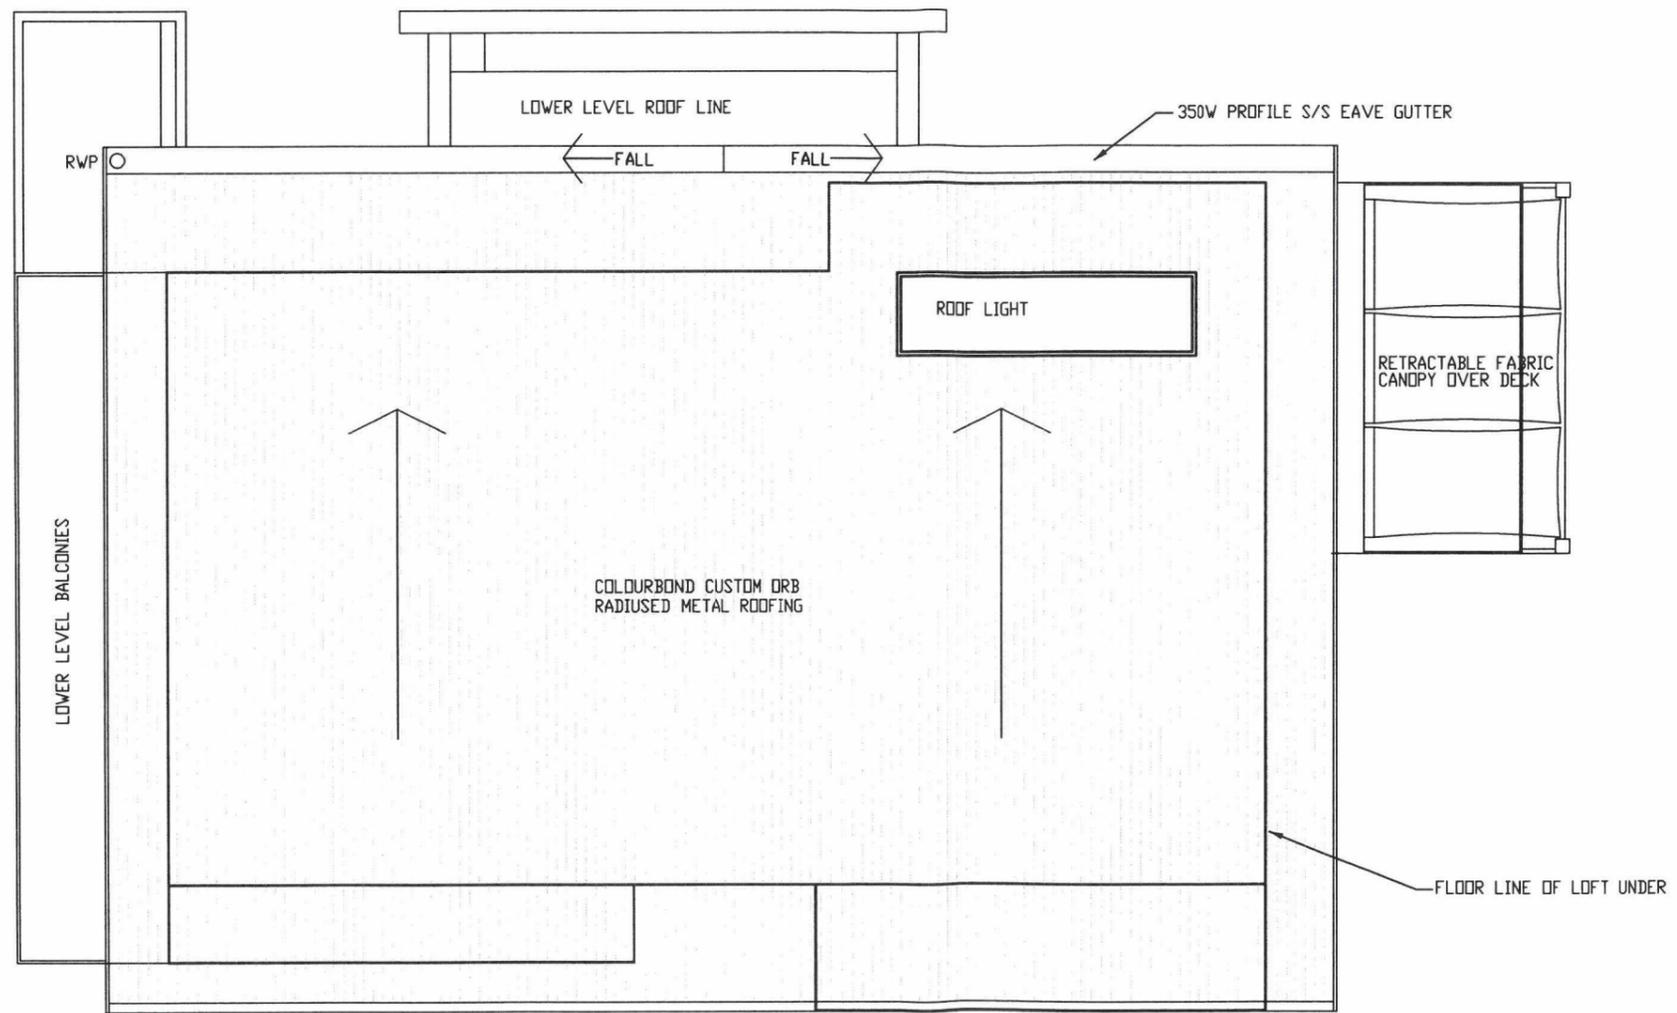

project/client
 PROPOSED RESIDENCE
 FOR
 GRANT JOHNSON
 AT
 REAR, No.39 (LO127)
 KNEBWORTH AVENUE
 NORTHBRIDGE

architects
CCN Cameron Chisholm & Nicol
 Architecture Interiors
 Urban Design Master Planning
 Level 1
 306 Murray Street, Perth
 Western Australia 6000
 (Postal P. O. Box F300)
 ACN 053 861 948
 ABN 81 053 861 948
 Telephone (08) 9322 1566
 Facsimile (08) 9481 0854
 Email perth@ccnarchitects.com.au
 Website www.ccnarchitects.com.au




CITY OF VINCENT
 PLANNING & BUILDING SERVICES
 APPROVED FOR USE
 IN ACCORDANCE WITH
 FORM M.P.S.2 ISSUED 19/02/15
 AND AMENDMENTS SHOWN IN RED
 19 FEB 2015
 aGroom for Manager, Planning & Building Services

drawing title
ROOF PLAN

© Copyright Cameron Chisholm & Nicol (WA) Pty Ltd
 scale 1:50 (A2) 2m
 approved _____ date drawn JUNE 2002
 proj no P0171 plot date 13-06-02
 discipline status dwg type floor dwg no rev no
 A B L I - 01 0


NOT FOR CONSTRUCTION

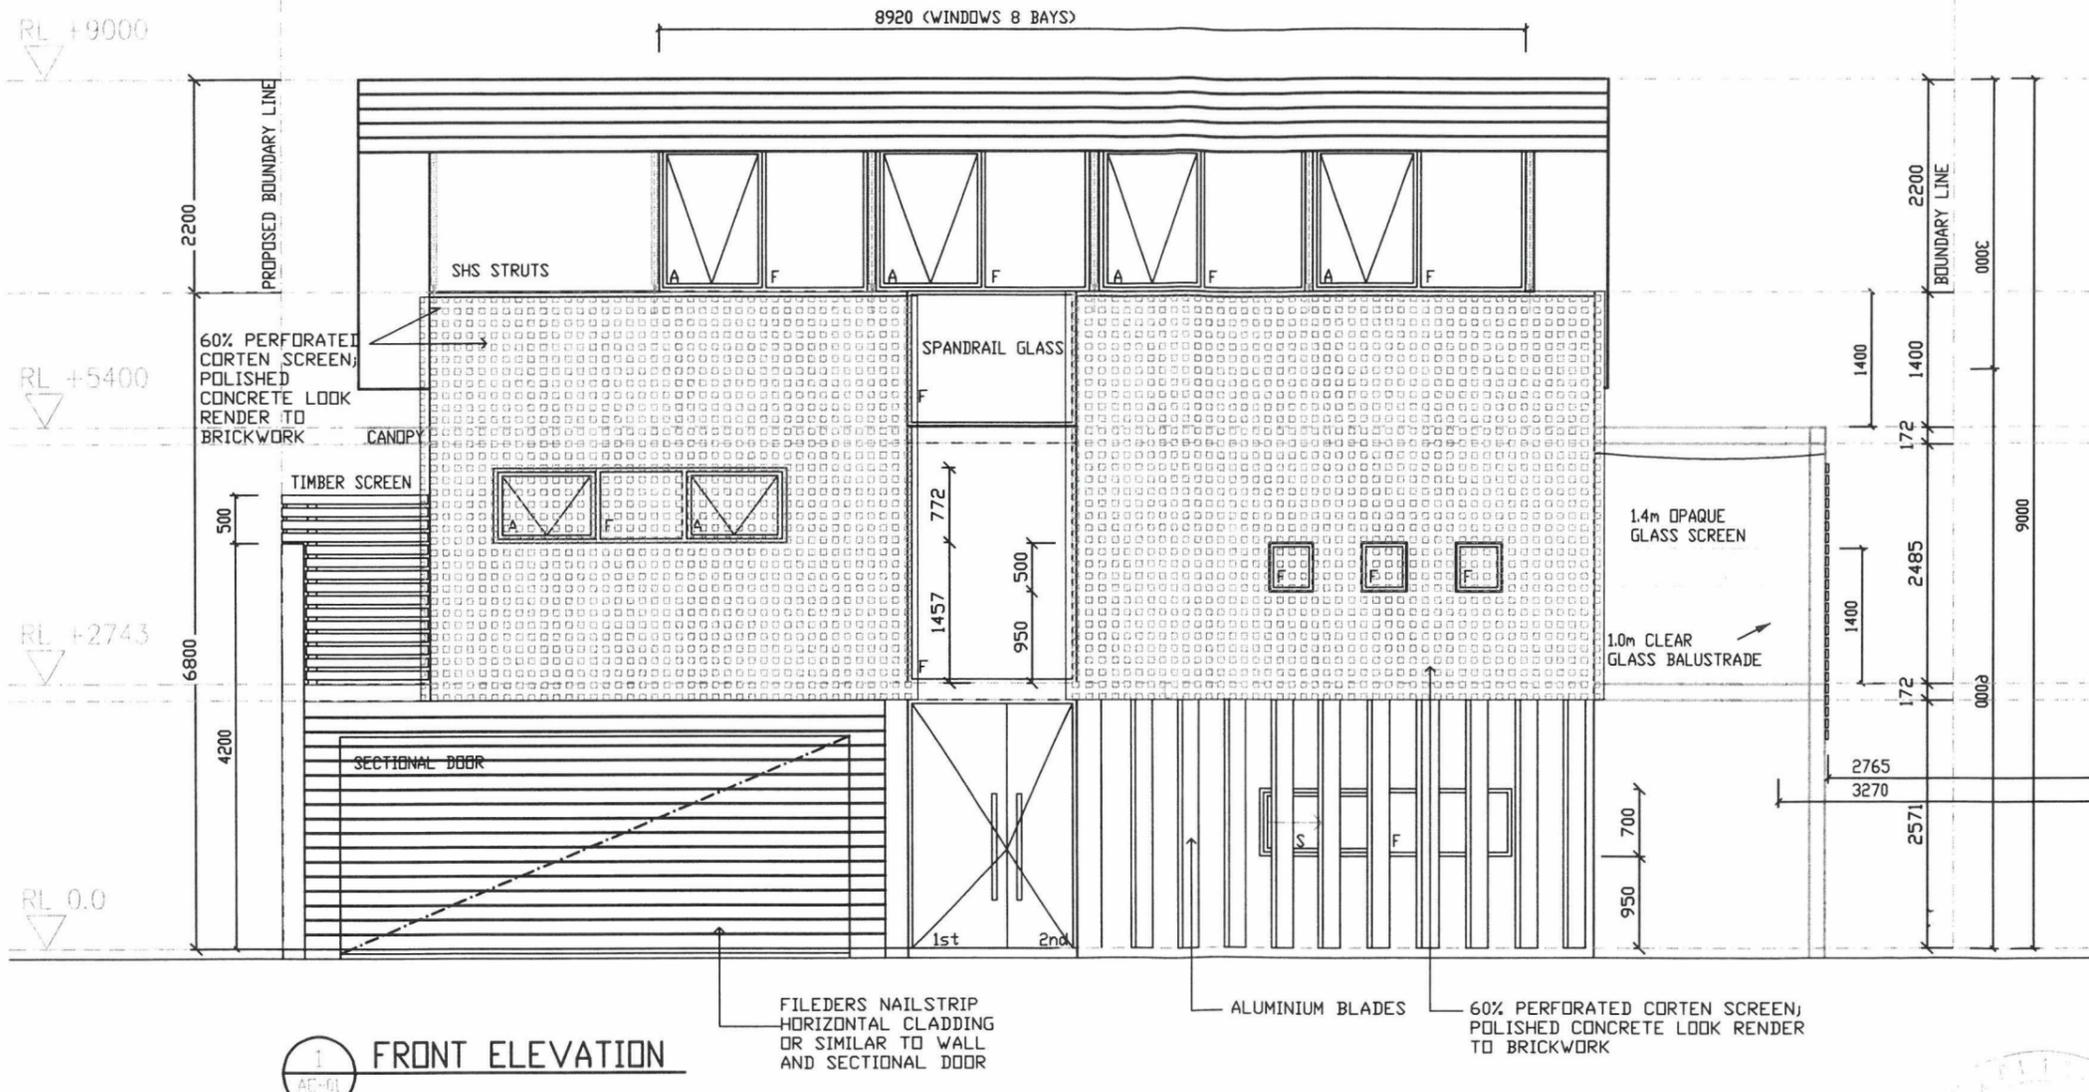

1 FRONT ELEVATION
AC-01

NOTES:
1. ONLY USE FIGURED DIMENSIONS
DO NOT SCALE FROM DRAWINGS

28/0/14	0	FOR DEVELOPMENT APPROVAL	
date	no	revision history	check

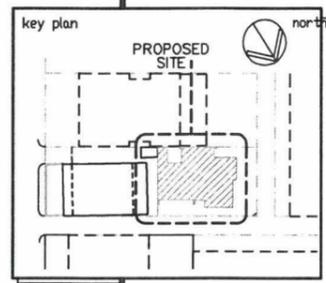

project/client
PROPOSED RESIDENCE
FOR
GRANT JOHNSON
AT
REAR, No. 39 (LOT 27)
KNEBWORTH AVENUE
NORTHBIDGE

architects
CCN Cameron
Chisholm &
Nicol

Architectural Interiors
Urban Design Master Planning
Level 1
306 Murray Street, Perth
Western Australia, 6000
(Postal P.O. Box F300)
ACN 053 861 948
ABN 81 053 861 948

Telephone (08) 9322 1566
Facsimile (08) 9481 0854
Email perth@ccnarchitects.com.au
Website www.ccnarchitects.com.au



CITY OF VINCENT
PLANNING & BUILDING SERVICES

APPROVED/REFUSED
IN ACCORDANCE WITH
19 FEB 2015

FORM M.P.S.2 ISSUED 19/02/15
AND AMENDMENTS SHOWN IN RED

AGroom for Manager, Planning & Building Services


PRELIMINARY
DRAWINGS

drawing title
NORTH EASTERN
ELEVATION

© Copyright Cameron Chisholm & Nicol (WA) Pty Ltd

scale	1:50 (A2)				
approved	date drawn JUNE 2002				
proj no	P0171				
plot date	08-06-2002				
discipline	status	dwg. type	floor	dwg. no.	rev. no.
A	BL	J	-	01	0


NOT FOR CONSTRUCTION

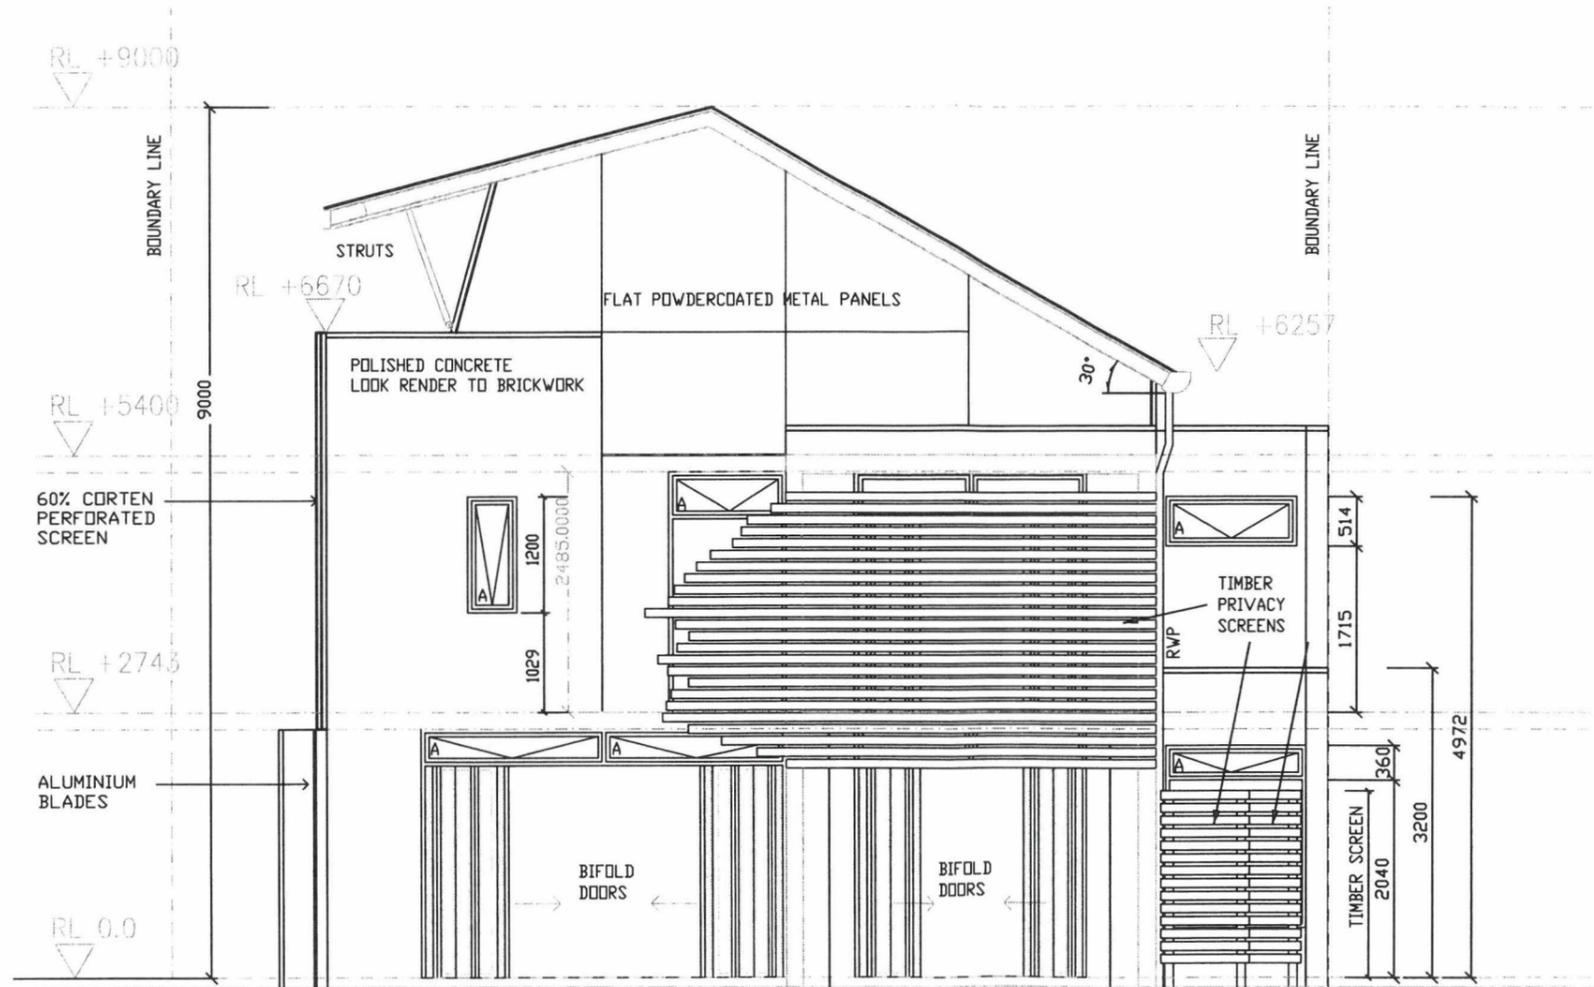

NOTES :

- ONLY USE FIGURED DIMENSIONS
DO NOT SCALE FROM DRAWINGS

28/0/14	0	FOR DEVELOPMENT APPROVAL	
date	no	revision history	check

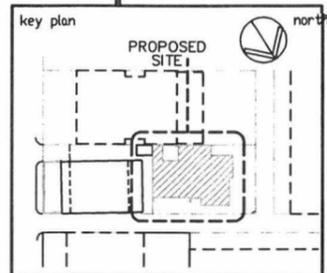

project/client
 PROPOSED RESIDENCE
 FOR
 GRANT JOHNSON
 AT
 REAR, No.39 (LOT27)
 KNEBWORTH AVENUE
 NORTHBRIDGE

architects
 Cameron
 Chisholm &
 Nicol

ArchitecturInteriors
 Urban DesignMaster Planning
 Level 1
 306 Murray Street, Perth
 Western Australia 6000
 (Postal P. O. Box F300)
 ACN 053 861 948
 ABN 81 053 861 948

Telephone (08) 9322 1566
 Facsimile (08) 9481 0854
 Email perth@ccnarchitects.com.au
 Website www.ccnarchitects.com.au

CITY OF VINCENT
 PLANNING & BUILDING SERVICES

~~APPROVED/REFUSED~~
 IN ACCORDANCE WITH

1 FEB 2015

FORM M.R.S.2 ISSUED 19/02/15
 AND AMENDMENTS SHOULD BE NOTED

AGroom for Manager Planning & Building Services



PRELIMINARY
 DRAWINGS


drawing title
 NORTH WESTERN
 ELEVATION

© Copyright Cameron Chisholm & Nicol (WA) Pty Ltd

scale
 1:50 (A2)

approved	date drawn	JUNE 2002
proj no	P0171	plot date
discipline	status	dwg type
A	BL	J - 02 0

LOT FOR CONSTRUCTION

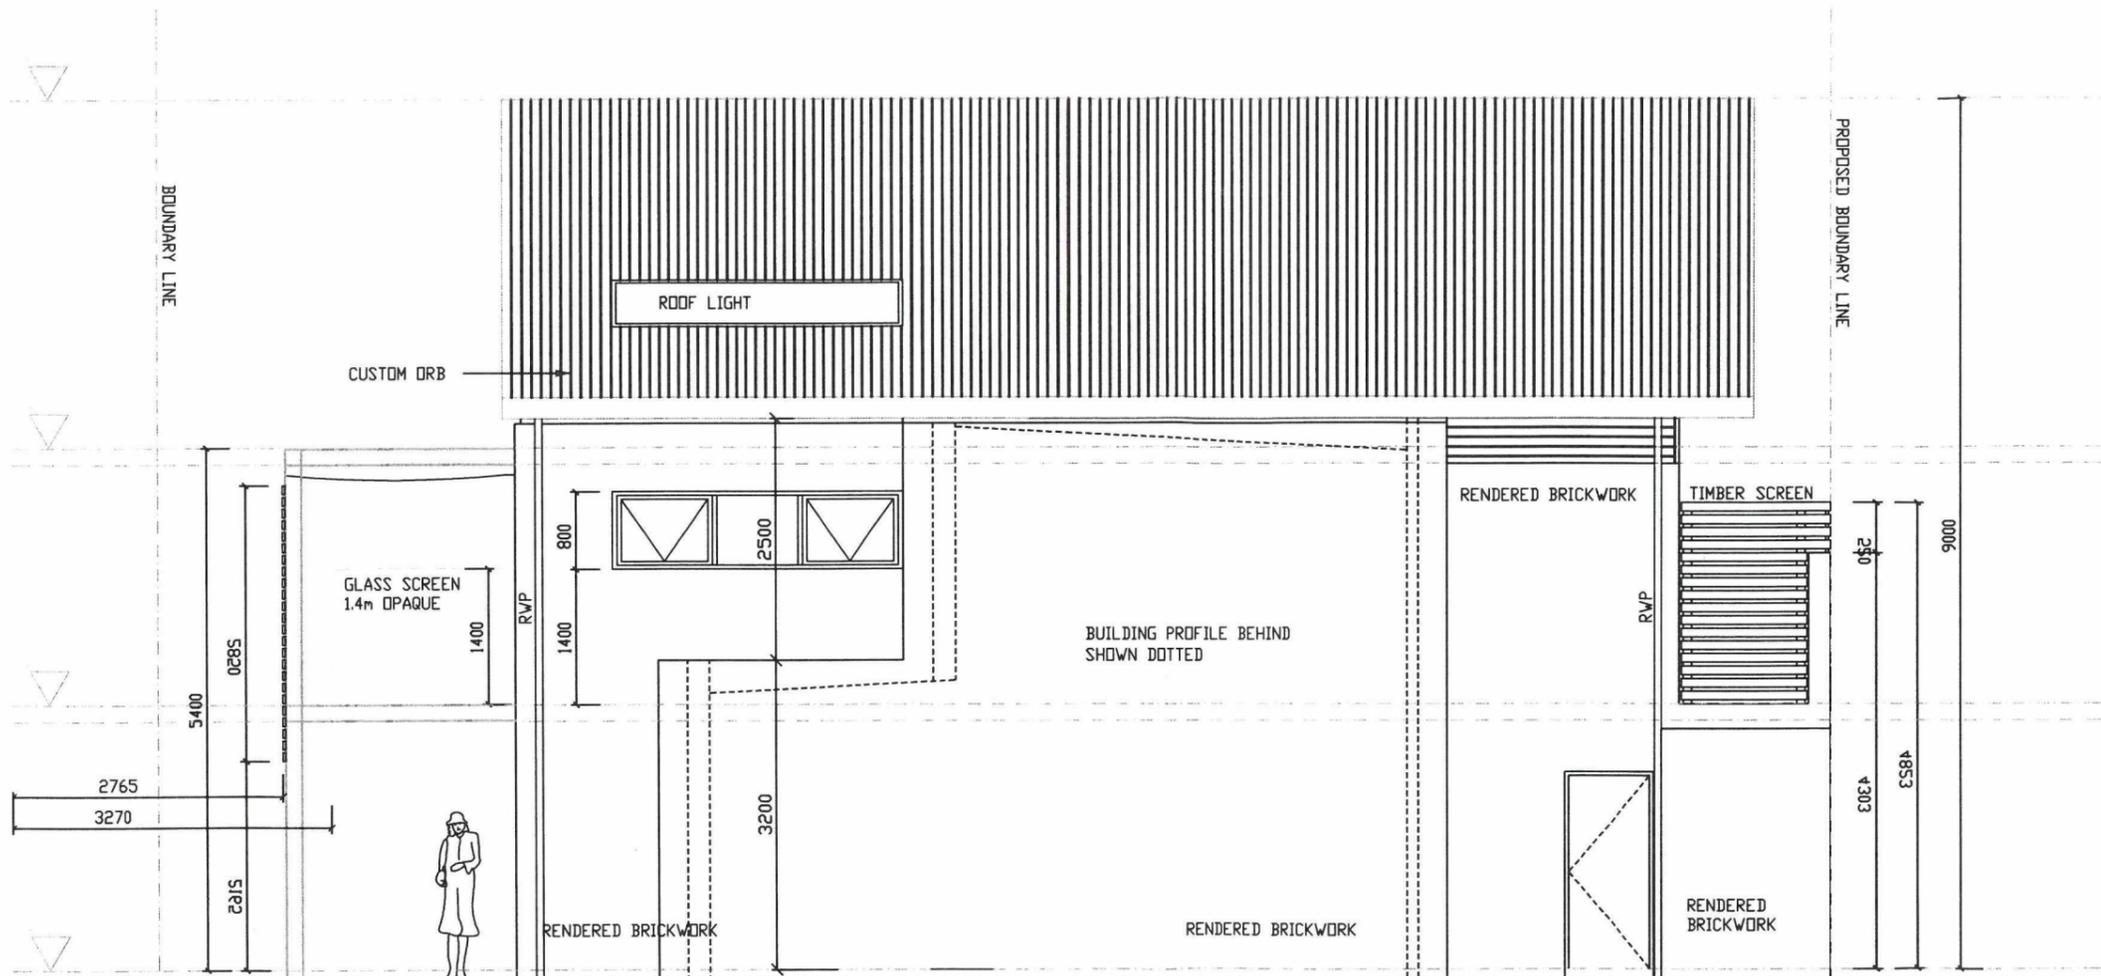


3 REAR ELEVATION SOUTH - WEST VIEW
AE-01

NOTES :

- ONLY USE FIGURED DIMENSIONS DO NOT SCALE FROM DRAWINGS

28/0/14	0	FOR DEVELOPMENT APPROVAL	
date	no	revision history	check

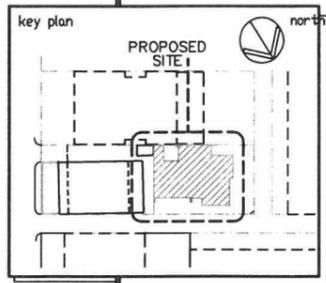

project/client
 PROPOSED RESIDENCE FOR GRANT JOHNSON AT REAR, No. 39 (LOT27) KNEBORTH AVENUE NORTHBRIDGE

architects
CCN Cameron Chisholm & Nicol
 Architecture Interiors Urban Design Master Planning Level 1
 306 Murray Street, Perth Western Australia, 6000
 (Postal P. O. Box F300) ACN 053 861 948 ABN 81 053 861 948
 Telephone (08) 9322 1566 Facsimile (08) 9481 0854 Email perth@ccnarchitects.com.au Website www.ccnarchitects.com.au




CITY OF MOUNT PLEASANT
 PLANNING & BUILDING SERVICES
 APPROVED/REFUSED IN ACCORDANCE WITH FORM M.R.S.2 ISSUED 19/02/15 AND AMENDMENTS SHOWN IN RED
 19 FEB 2015
 A Groom for Manager Planning & Building Services

PRELIMINARY DRAWINGS

drawing title
 SOUTH WESTERN ELEVATION

© Copyright Cameron Chisholm & Nicol (WA) Pty Ltd
 scale 1:50 (A2)
 approved date drawn JUNE 2002
 proj no P0171 plot date 28-06-2002
 discipline status dwg type floor dwg no. rev no
 A BL J - 03 0

LOT FOR CONSTRUCTION

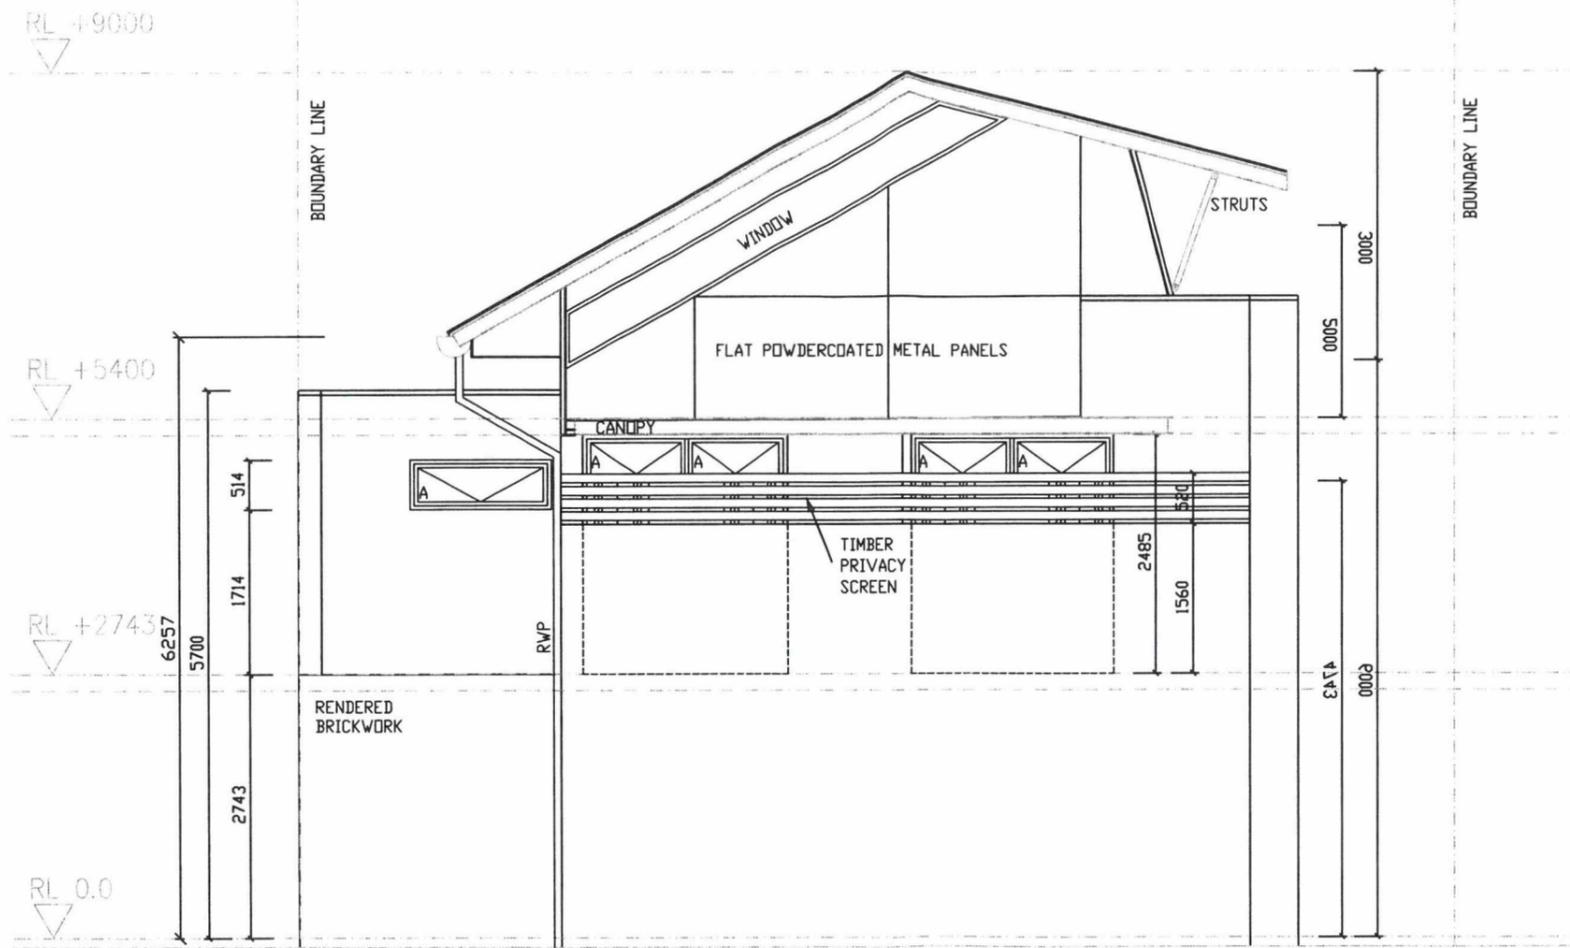


4 SIDE ELEVATION
AE-01 SOUTH - EAST VIEW

NOTES :

1. ONLY USE FIGURED DIMENSIONS
DO NOT SCALE FROM DRAWINGS

28/0/14	0	FOR DEVELOPMENT APPROVAL	
date	no	revision history	check

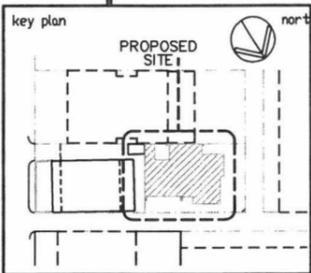

project/client
PROPOSED RESIDENCE
FOR
GRANT JOHNSON
AT
REAR, No.39 (LOT27)
KNEBWORTH AVENUE
NORTHBRIDGE

architects
CCN Cameron
Chisholm &
Nicol

ArchitecturInteriors
Urban DesignMaster Planning
Level 1
306 Murray Street, Perth
Western Australia 6000
(Postal P. O. Box F300)
ACN 053 861 948
ABN 81 053 861 948

Telephone (08) 9322 1566
Facsimile (08) 9481 0854
Email perth@ccnarchitects.com.au
Website www.ccnarchitects.com.au

drawing title
SOUTH EASTERN
ELEVATION

© Copyright Cameron Chisholm & Nicol (WA) Pty Ltd

scale
1:50 (A2)

approved	date drawn	JUNE 2002
proj no	P0171	plot date
discipline	status	dwg type
A	BL	J - 04 0


CITY OF VINCENT
PLANNING & BUILDING SERVICES

APPROVED
IN ACCORDANCE WITH

FORM M.R.S.2 ISSUED 19/02/15
AND AMENDMENTS SHOWN IN RED

19 FEB 2015

A Groon for Manager, Planning & Building Services

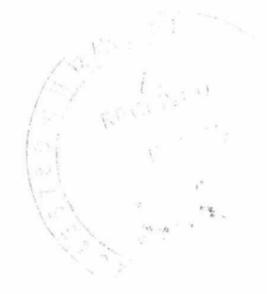

PRELIMINARY
DRAWINGS