

9.1.1 Nos. 33 – 35 (Lots 53 & 350; D/P: 672 & 302361) Mary Street, Highgate – Proposed Additions and Alterations of an Existing Eight Multiple Dwelling Development to a Seven Multiple Dwelling Development and Construction of Two Grouped Dwellings

Ward:	South	Date:	12 June 2015
Precinct:	Precinct 12 – Hyde Park	File Ref:	PR23873; 5.2014.716.1
Attachments:	<u>1</u> – Consultation Map <u>2</u> – Development Application Plans <u>3</u> – Applicant Submission <u>4</u> – Applicant Justification <u>5</u> – Heritage Impact Statement <u>6</u> – Heritage Assessment from Applicant <u>7</u> – Marked up plans showing proposed versus required setbacks <u>8</u> – 3D Perspectives <u>9</u> – Design Advisory Committee Comments		
Tabled Items:	Nil		
Reporting Officer:	A Dyson – Planning Officer (Statutory)		
Responsible Officer:	G Poezyn – Director Planning Services		

OFFICER RECOMMENDATION:

That Council, in accordance with the provisions of the City of Vincent Town Planning Scheme No. 1 and the Metropolitan Region Scheme, APPROVES the application submitted by John Kestel Architect on behalf of the owner L & P Squire, for the proposed additions and alterations of an existing eight Multiple Dwelling development to a seven Multiple Dwelling development and construction of Two Grouped Dwellings at Nos. 33 & 35 (Lots 53 & 350) Mary Street, Highgate as shown on plans date stamped 24 December 2014 (site survey and existing floor plan) and amended plans date stamped 27 February 2015 (Shadow Plan) and 2 June 2015 (undercroft floor plan, ground and upper floor plans, elevation plans, Strata Plans), included as Attachment 2, subject to the following conditions:

1. Amalgamation

Nos. 33-35 (Lots 53, and 350) Mary Street, Highgate shall be amalgamated into one lot on a Certificate of Title to the satisfaction of the City;

2. Legal Agreement

The owners shall enter into a legal agreement secured by a caveat on the Certificate of Title of the amalgamated lot, for the conservation of the existing multiple dwellings to the satisfaction of the City;

3. Boundary Walls

The owners of the subject land shall finish and maintain the surface of the boundary (parapet) walls facing Nos. 31 (Lot 51) and 37 (Lot 54) Mary Street, Highgate, in a good and clean condition. The finish of the walls is to be to the satisfaction of the City and can either be fully rendered or face brickwork;

4. Building Appearance

All external fixtures shall be designed integrally with the development and shall not be visually obtrusive from Mary Street and neighbouring properties. External fixtures are such things as television antennas (of a non-standard type), radio and other antennas, satellite dishes, external hot water heaters, air conditioners, and the like;

5. Street Trees

No street verge tree on Mary Street shall be removed. The street verge trees are to be retained and protected from any damage including unauthorised pruning;

6. On-Site Parking Provision

The following minimum number of car bays shall be provided

- 6.1 Five car bays for the residents of the multiple dwelling component;
- 6.2 Two visitor car bays for the multiple dwelling component; and
- 6.3 Two car bays for the grouped dwelling component;

7. Car Parking and Accessways

- 7.1 The car parking and access areas are to comply with the requirements of AS2890.1;
- 7.2 The car park areas for visitors shall be shown as common property on any strata plan; and
- 7.3 Vehicle and pedestrian access points are required to match into existing right-of-way levels;

8. Car Parking Permits

A notice being placed on the Sales Contract to advise prospective purchasers that the City of Vincent will not issue a residential or visitor car parking permit to any owner or occupier of the residential dwelling;

9. Within 28 days of the issue date of this approval to commence development, the owner or the applicant on behalf of the owner shall comply with the following requirements:

9.1 Section 70A Notification under the *Transfer of Land Act 1893*

The owner shall agree in writing to a notification being lodged under section 70A of the *Transfer of Land Act 1893* notifying proprietors and/or (prospective) purchasers of the property that:

- a. The use or enjoyment of the property may be affected by traffic, car parking and other impacts associated with nearby commercial and non-residential activities;

10. Prior to the submission of a Building Permit application, the following shall be submitted to and approved by the City:

10.1 Revised Plans

The applicant to provide revised plans denoting the following:

10.1.1 Visual Privacy

The southern façade of the balconies to units 8 & 9 shall comply with the requirements of the 2013 Residential Design Codes in relation to privacy provisions to the satisfaction of the City to prevent overlooking of Nos. 31 (Lot 51) and 37 (Lot 54) Mary Street, Highgate;

10.1.2 Bicycle Bays

Three residential and one visitor bicycle bays respectively for the residents and visitors of the development, shall be provided. Bicycle bays for visitors must be provided at a location convenient to the entrance, publically accessible and within the development and bicycle bays for the residents and employees must be located within the development. The bicycle facilities shall be designed in accordance with AS2890.3; and

10.1.3 Bin Store

A bin store is required to be provided, of a sufficient size to accommodate the City's maximum bin requirement, as assessed by the City;

10.2 Landscaping

A detailed landscape plan for the development site drawn to a scale of 1:100 shall show the following:

- 10.2.1 The location and type of existing and proposed trees and plants;
- 10.2.2 All vegetation including lawns;
- 10.2.3 Areas to be irrigated or reticulated and such method;
- 10.2.4 Proposed watering system to ensure the establishment of species and their survival during the hot and dry months; and
- 10.2.5 Separate soft and hard landscaping plants (indicating details of materials to be used);

10.3 Vehicle Entry Gate – Management Plan

The proposed vehicular entry gate to the car parking area shall have a minimum 50% visual permeability or a plan detailing management measures for the operation of the vehicular entry gate, to ensure access is readily available for owners/visitors to the units at all times;

10.4 Acoustic Report

An Acoustic Report in accordance with the City's Policy No. 7.5.21 – Sound Attenuation shall be prepared, submitted and approved by the City. The recommended measures of the report shall be implemented; and

10.5 Construction Management Plan

A Construction Management Plan, detailing how the construction of the development will be managed to minimise the impact on the surrounding area, in accordance with the requirements of the City's Policy No. 7.5.23 – Construction Management Plans. Construction and management of the site shall thereafter comply with the approved Construction Management Plan; and

11. Prior to the submission of an Occupancy Permit, the following shall be completed to the satisfaction of the City;

11.1 Car Parking

The car parking bays shall be line marked in accordance with the approved plans and maintained thereafter by the owners/occupiers to the satisfaction of the City;

11.2 Clothes Drying Facility

Each multiple dwelling shall be provided with a clothes drying facility in accordance with the 2013 Residential Design Codes;

11.3 Acoustic Report

With reference to Condition 10.4, certification from an acoustic consultant, that the recommended measures have been undertaken shall be provided to the City;

11.4 Section 70 A notification under the *Transfer of Land Act 1893*

With reference to Condition 8.1, this notification shall be lodged and registered in accordance with the *Transfer of Land Act 1893*;

11.5 Stormwater

All stormwater produced on the subject land shall be retained on site, by suitable means to the satisfaction of the City; and

11.6 Landscaping

With reference to Condition 10.2 all such works shown shall be undertaken in accordance with the approved plan and maintained thereafter, to the satisfaction of the City, by the owners/occupiers.

ADVICE NOTES:

1. With regard to Condition 1 the owners shall enter into a legal agreement with and lodge an appropriate assurance bond/bank guarantee to the satisfaction of the City, which is secured by a caveat on the Certificates of Title of the subject land, prepared by the City's solicitors or other solicitors agreed upon by the City, undertaking to amalgamate the subject land into one lot within 6 months of the issue of the subject Building Permit. All costs associated with this condition shall be borne by the applicant/owner(s). Amalgamation of the lots is not required if it can be demonstrated that the proposed development complies with the relevant requirements of the National Construction Code Series;
2. With regard to Condition 2, all costs associated with this condition shall be borne by the applicant/owners;

3. With regard to Condition 3, the owners of the subject land shall obtain the consent of the owners of relevant adjoining properties before entering those properties in order to make good the boundary walls;
4. A Demolition Permit shall be obtained from the City prior to commencement of any demolition works on the site;
5. With regard to Condition 11.5, no further consideration shall be given to the disposal of stormwater 'off site' without the submission of a geotechnical report from a qualified consultant. Should approval to dispose of stormwater 'off site' be subsequently provided, detailed design drainage plans and associated calculations for the proposed stormwater disposal shall be lodged together with the building permit application working drawings;
6. A Road and Verge security bond for the sum of \$3,000, shall be lodged with the City by the applicant, prior to the issue of a building permit, and will be held until all building/development works have been completed and any disturbance of, or damage to the City's infrastructure, including verge trees, has been repaired/reinstated to the satisfaction of the City. An application for the refund of the security bond shall be made in writing. The bond is non-transferable;
7. With regard to Condition 7.3, the portion of the existing footpath traversing the proposed crossover must be retained. The proposed crossover levels shall match into the existing footpath levels. Should the footpath not be deemed to be in satisfactory condition, it must be replaced with in-situ concrete panels in accordance with the City's specification for reinstatement of concrete paths;
8. With regard to Condition 10.2, Council encourages landscaping methods and species selection which do not rely on reticulation;
9. With regard to Condition 10.1.3, the bins access pathway is to be ramped or a mechanical lift to be fitted to allow waste and recycle bins to be taken to Mary Street for collection.
10. With regard to Condition 10.1.2, the bicycle bays are to be incorporated into the development.
11. Please note that any additional property numbering to the abovementioned address which results from this application will be allocated by the City of Vincent. Please liaise with the City in this regard during the building permit process;
12. With regard to Condition 10.2, Council encourages landscaping methods and species selection which do not rely on reticulation. All such works shall be undertaken in accordance with the approved plans prior to the first occupation of the development, and maintained thereafter by the owners/occupiers; and
13. The movement of all path users, with or without disabilities, within the road reserve, shall not be impeded in any way during the course of the building works. This area shall be maintained in a safe and trafficable condition and a continuous path of travel (minimum width 1.5m) shall be maintained for all users at all times during construction works. If the safety of the path is compromised resulting from either construction damage or as a result of a temporary obstruction appropriate warning signs (in accordance with AS1742.3) shall be erected. Should a continuous path not be able to be maintained, an 'approved' temporary pedestrian facility suitable for all path users shall be put in place. If there is a request to erect scaffolding, site fencing etc. or if building materials are required to be stored within the road reserve, once a formal request has been received, the matter will be assessed by the City and if considered appropriate a permit shall be issued by the City's Ranger Services Section. No permit will be issued if the proposed encroachment into the road reserve is deemed to be inappropriate.

Moved Cr Cole, Seconded Cr Peart

That the recommendation be adopted.

Debate ensued.

Cr Cole departed the Chamber at 7.10pm.

Cr Cole returned to the Chamber at 7.13pm.

Debate ensued.

AMENDMENT

Moved Cr Harley, Seconded Cr McDonald

That a new Advice Note be inserted as follows:

14. The applicant shall pay a laneway security bond in the amount determined by the Director of Technical Services, prior to the issue of a building permit.

AMENDMENT PUT AND CARRIED UNANIMOUSLY (7-0)

(Cr Buckels was on approved leave of absence.)

(Cr Pintabona was an apology for the Meeting.)

MOTION AS AMENDED PUT AND CARRIED UNANIMOUSLY (7-0)

(Cr Buckels was on approved leave of absence.)

(Cr Pintabona was an apology for the Meeting.)

COUNCIL DECISION ITEM 9.1.1

That Council, in accordance with the provisions of the City of Vincent Town Planning Scheme No. 1 and the Metropolitan Region Scheme, APPROVES the application submitted by John Kestel Architect on behalf of the owner L & P Squire, for the proposed additions and alterations of an existing eight Multiple Dwelling development to a seven Multiple Dwelling development and construction of Two Grouped Dwellings at Nos. 33 & 35 (Lots 53 & 350) Mary Street, Highgate as shown on plans date stamped 24 December 2014 (site survey and existing floor plan) and amended plans date stamped 27 February 2015 (Shadow Plan) and 2 June 2015 (undercroft floor plan, ground and upper floor plans, elevation plans, Strata Plans), included as Attachment 2, subject to the following conditions:

1. Amalgamation

Nos. 33-35 (Lots 53, and 350) Mary Street, Highgate shall be amalgamated into one lot on a Certificate of Title to the satisfaction of the City;

2. Legal Agreement

The owners shall enter into a legal agreement secured by a caveat on the Certificate of Title of the amalgamated lot, for the conservation of the existing multiple dwellings to the satisfaction of the City;

3. Boundary Walls

The owners of the subject land shall finish and maintain the surface of the boundary (parapet) walls facing Nos. 31 (Lot 51) and 37 (Lot 54) Mary Street, Highgate, in a good and clean condition. The finish of the walls is to be to the satisfaction of the City and can either be fully rendered or face brickwork;

4. Building Appearance

All external fixtures shall be designed integrally with the development and shall not be visually obtrusive from Mary Street and neighbouring properties. External fixtures are such things as television antennas (of a non-standard type), radio and other antennas, satellite dishes, external hot water heaters, air conditioners, and the like;

5. Street Trees

No street verge tree on Mary Street shall be removed. The street verge trees are to be retained and protected from any damage including unauthorised pruning;

6. On-Site Parking Provision

The following minimum number of car bays shall be provided

- 6.1 Five car bays for the residents of the multiple dwelling component;
- 6.2 Two visitor car bays for the multiple dwelling component; and
- 6.3 Two car bays for the grouped dwelling component;

7. Car Parking and Accessways

- 7.1 The car parking and access areas are to comply with the requirements of AS2890.1;
- 7.2 The car park areas for visitors shall be shown as common property on any strata plan; and
- 7.3 Vehicle and pedestrian access points are required to match into existing right-of-way levels;

8. Car Parking Permits

A notice being placed on the Sales Contract to advise prospective purchasers that the City of Vincent will not issue a residential or visitor car parking permit to any owner or occupier of the residential dwelling;

- 9. Within 28 days of the issue date of this approval to commence development, the owner or the applicant on behalf of the owner shall comply with the following requirements:

9.1 Section 70A Notification under the *Transfer of Land Act 1893*

The owner shall agree in writing to a notification being lodged under section 70A of the *Transfer of Land Act 1893* notifying proprietors and/or (prospective) purchasers of the property that:

- a. The use or enjoyment of the property may be affected by traffic, car parking and other impacts associated with nearby commercial and non-residential activities;

10. Prior to the submission of a Building Permit application, the following shall be submitted to and approved by the City:

10.1 Revised Plans

The applicant to provide revised plans denoting the following:

10.1.1 Visual Privacy

The southern façade of the balconies to units 8 & 9 shall comply with the requirements of the 2013 Residential Design Codes in relation to privacy provisions to the satisfaction of the City to prevent overlooking of Nos. 31 (Lot 51) and 37 (Lot 54) Mary Street, Highgate;

10.1.2 Bicycle Bays

Three residential and one visitor bicycle bays respectively for the residents and visitors of the development, shall be provided. Bicycle bays for visitors must be provided at a location convenient to the entrance, publically accessible and within the development and bicycle bays for the residents and employees must be located within the development. The bicycle facilities shall be designed in accordance with AS2890.3; and

10.1.3 Bin Store

A bin store is required to be provided, of a sufficient size to accommodate the City's maximum bin requirement, as assessed by the City;

10.2 Landscaping

A detailed landscape plan for the development site drawn to a scale of 1:100 shall show the following:

- 10.2.1 The location and type of existing and proposed trees and plants;
- 10.2.2 All vegetation including lawns;
- 10.2.3 Areas to be irrigated or reticulated and such method;
- 10.2.4 Proposed watering system to ensure the establishment of species and their survival during the hot and dry months; and
- 10.2.5 Separate soft and hard landscaping plants (indicating details of materials to be used);

10.3 Vehicle Entry Gate – Management Plan

The proposed vehicular entry gate to the car parking area shall have a minimum 50% visual permeability or a plan detailing management measures for the operation of the vehicular entry gate, to ensure access is readily available for owners/visitors to the units at all times;

10.4 Acoustic Report

An Acoustic Report in accordance with the City's Policy No. 7.5.21 – Sound Attenuation shall be prepared, submitted and approved by the City. The recommended measures of the report shall be implemented; and

10.5 Construction Management Plan

A Construction Management Plan, detailing how the construction of the development will be managed to minimise the impact on the surrounding area, in accordance with the requirements of the City's Policy No. 7.5.23 – Construction Management Plans. Construction and management of the site shall thereafter comply with the approved Construction Management Plan; and

11. Prior to the submission of an Occupancy Permit, the following shall be completed to the satisfaction of the City;

11.1 Car Parking

The car parking bays shall be line marked in accordance with the approved plans and maintained thereafter by the owners/occupiers to the satisfaction of the City;

11.2 Clothes Drying Facility

Each multiple dwelling shall be provided with a clothes drying facility in accordance with the 2013 Residential Design Codes;

11.3 Acoustic Report

With reference to Condition 10.4, certification from an acoustic consultant, that the recommended measures have been undertaken shall be provided to the City;

11.4 Section 70 A notification under the *Transfer of Land Act 1893*

With reference to Condition 8.1, this notification shall be lodged and registered in accordance with the *Transfer of Land Act 1893*;

11.5 Stormwater

All stormwater produced on the subject land shall be retained on site, by suitable means to the satisfaction of the City; and


11.6 Landscaping

With reference to Condition 10.2 all such works shown shall be undertaken in accordance with the approved plan and maintained thereafter, to the satisfaction of the City, by the owners/occupiers.


ADVICE NOTES:

1. With regard to Condition 1 the owners shall enter into a legal agreement with and lodge an appropriate assurance bond/bank guarantee to the satisfaction of the City, which is secured by a caveat on the Certificates of Title of the subject land, prepared by the City's solicitors or other solicitors agreed upon by the City, undertaking to amalgamate the subject land into one lot within 6 months of the issue of the subject Building Permit. All costs associated with this condition shall be borne by the applicant/owner(s). Amalgamation of the lots is not required if it can be demonstrated that the proposed development complies with the relevant requirements of the National Construction Code Series;
2. With regard to Condition 2, all costs associated with this condition shall be borne by the applicant/owners;


3. With regard to Condition 3, the owners of the subject land shall obtain the consent of the owners of relevant adjoining properties before entering those properties in order to make good the boundary walls;
4. A Demolition Permit shall be obtained from the City prior to commencement of any demolition works on the site;
5. With regard to Condition 11.5, no further consideration shall be given to the disposal of stormwater 'off site' without the submission of a geotechnical report from a qualified consultant. Should approval to dispose of stormwater 'off site' be subsequently provided, detailed design drainage plans and associated calculations for the proposed stormwater disposal shall be lodged together with the building permit application working drawings;
6. A Road and Verge security bond for the sum of \$3,000, shall be lodged with the City by the applicant, prior to the issue of a building permit, and will be held until all building/development works have been completed and any disturbance of, or damage to the City's infrastructure, including verge trees, has been repaired/reinstated to the satisfaction of the City. An application for the refund of the security bond shall be made in writing. The bond is non-transferable;
7. With regard to Condition 7.3, the portion of the existing footpath traversing the proposed crossover must be retained. The proposed crossover levels shall match into the existing footpath levels. Should the footpath not be deemed to be in satisfactory condition, it must be replaced with in-situ concrete panels in accordance with the City's specification for reinstatement of concrete paths;
8. With regard to Condition 10.2, Council encourages landscaping methods and species selection which do not rely on reticulation;
9. With regard to Condition 10.1.3, the bins access pathway is to be ramped or a mechanical lift to be fitted to allow waste and recycle bins to be taken to Mary Street for collection.
10. With regard to Condition 10.1.2, the bicycle bays are to be incorporated into the development.
11. Please note that any additional property numbering to the abovementioned address which results from this application will be allocated by the City of Vincent. Please liaise with the City in this regard during the building permit process;
12. With regard to Condition 10.2, Council encourages landscaping methods and species selection which do not rely on reticulation. All such works shall be undertaken in accordance with the approved plans prior to the first occupation of the development, and maintained thereafter by the owners/occupiers; and
13. The movement of all path users, with or without disabilities, within the road reserve, shall not be impeded in any way during the course of the building works. This area shall be maintained in a safe and trafficable condition and a continuous path of travel (minimum width 1.5m) shall be maintained for all users at all times during construction works. If the safety of the path is compromised resulting from either construction damage or as a result of a temporary obstruction appropriate warning signs (in accordance with AS1742.3) shall be erected. Should a continuous path not be able to be maintained, an 'approved' temporary pedestrian facility suitable for all path users shall be put in place. If there is a request to erect scaffolding, site fencing etc. or if building materials are required to be stored within the road reserve, once a formal request has been received, the matter will be assessed by the City and if considered appropriate a permit shall be issued by the City's Ranger Services Section. No permit will be issued if the proposed encroachment into the road reserve is deemed to be inappropriate.
14. The applicant shall pay a laneway security bond in the amount determined by the Director of Technical Services, prior to the issue of a building permit.

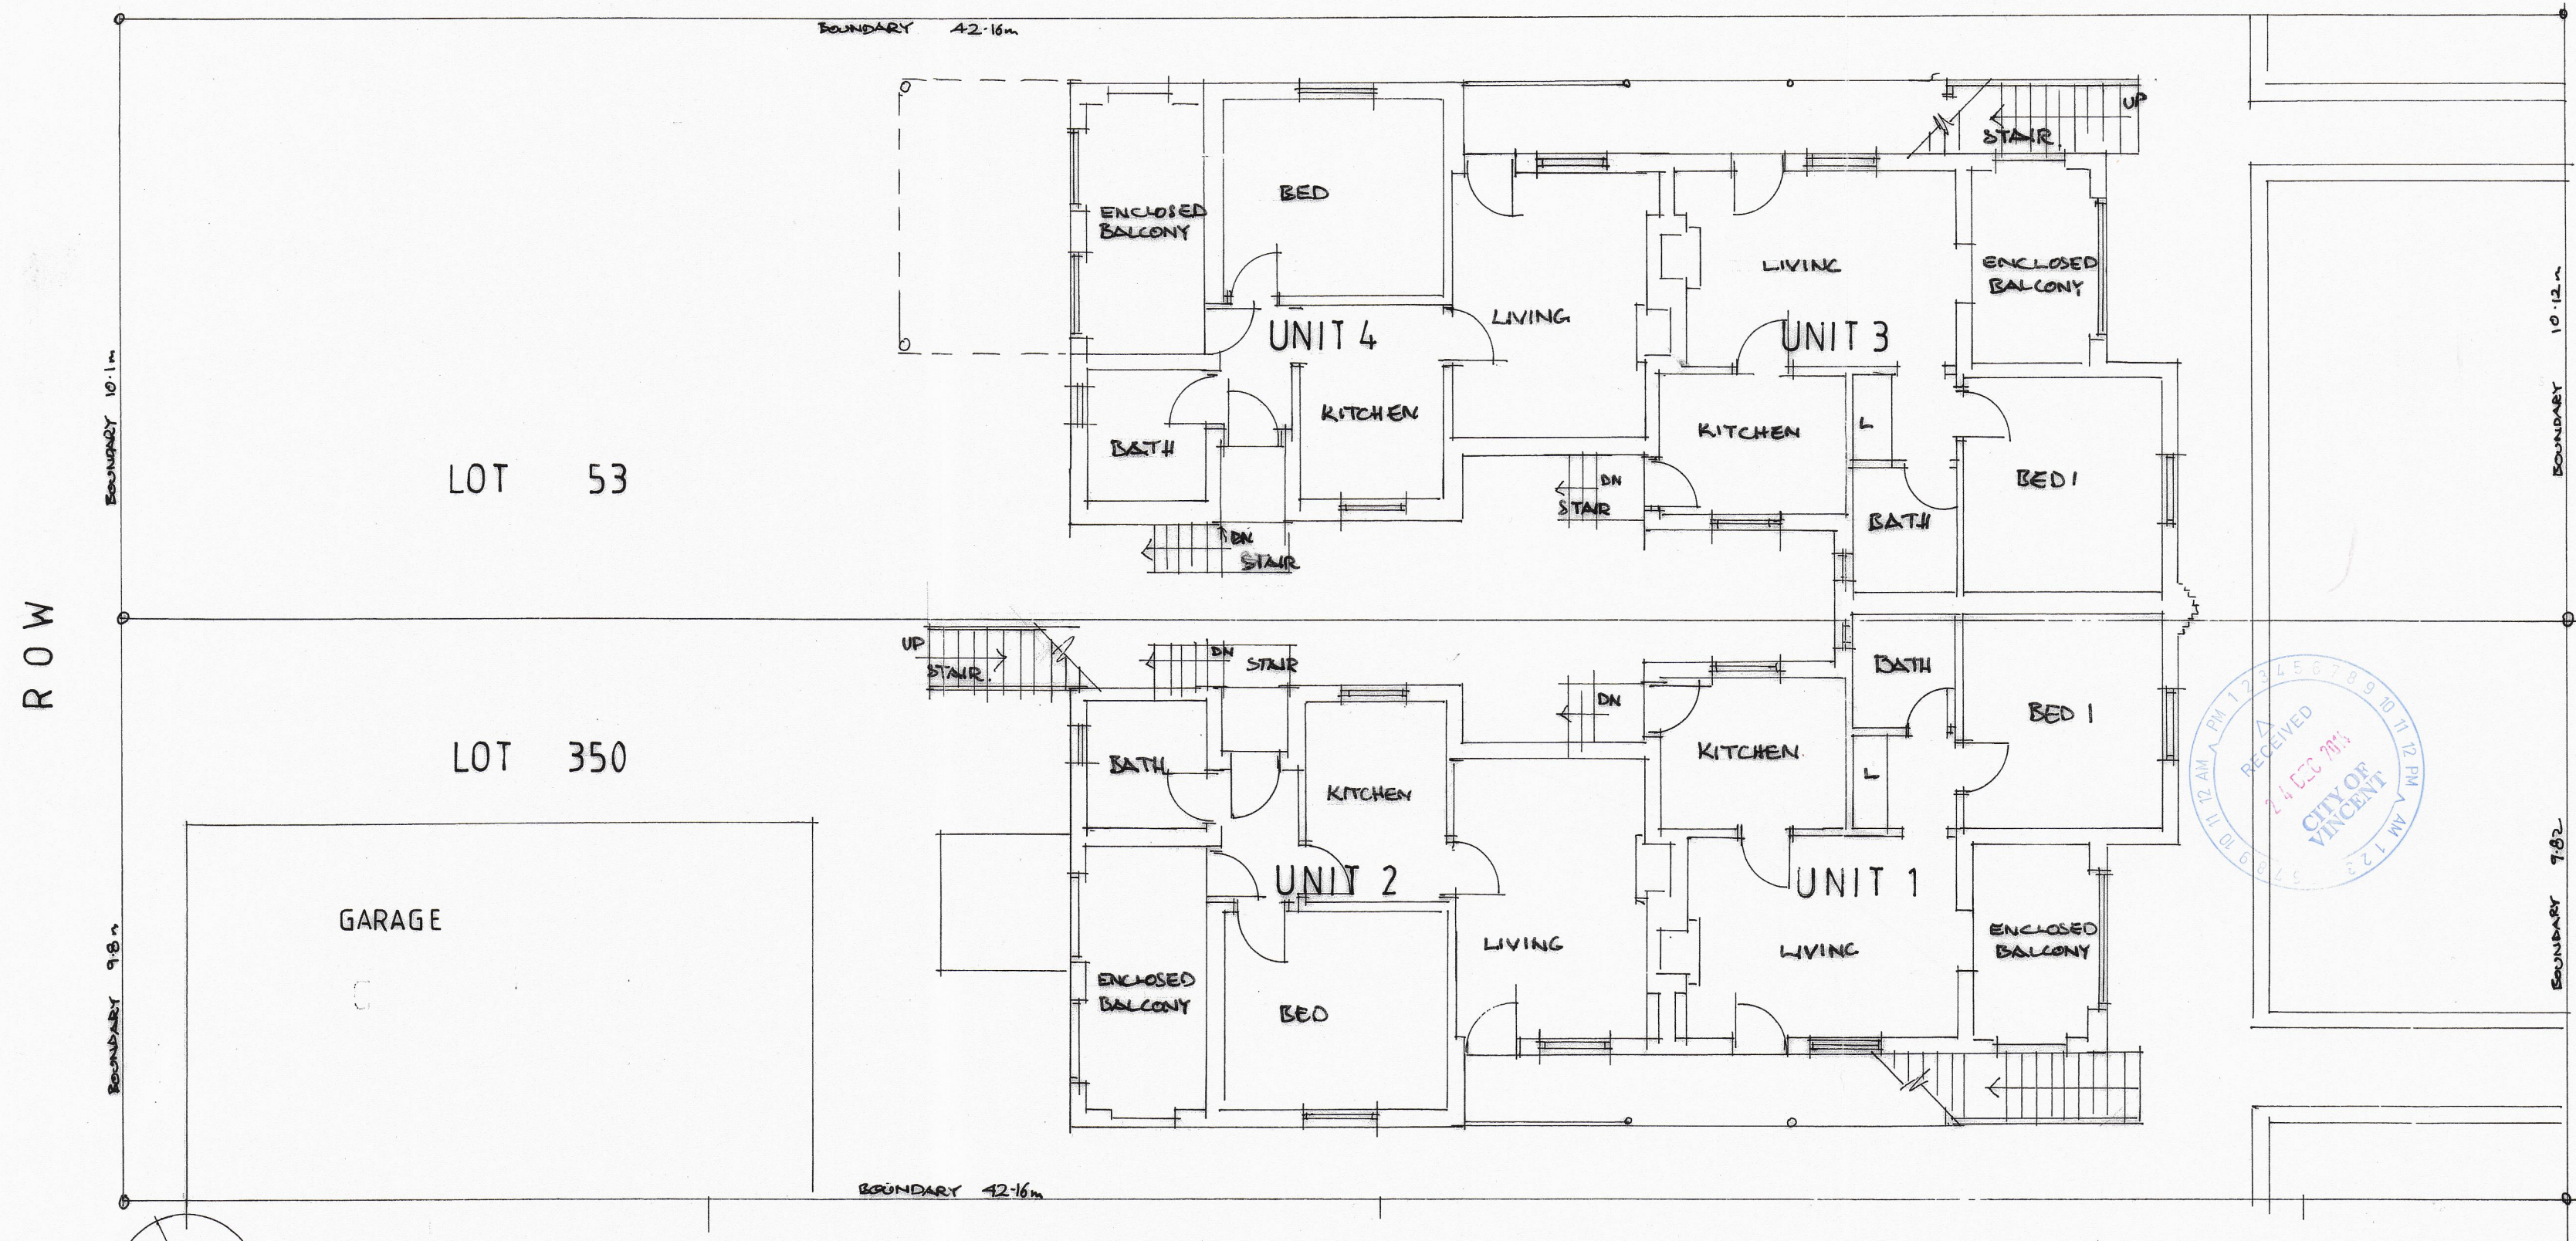

EXIST. SITE & GROUND FLOOR PLAN
SCALE 1:100

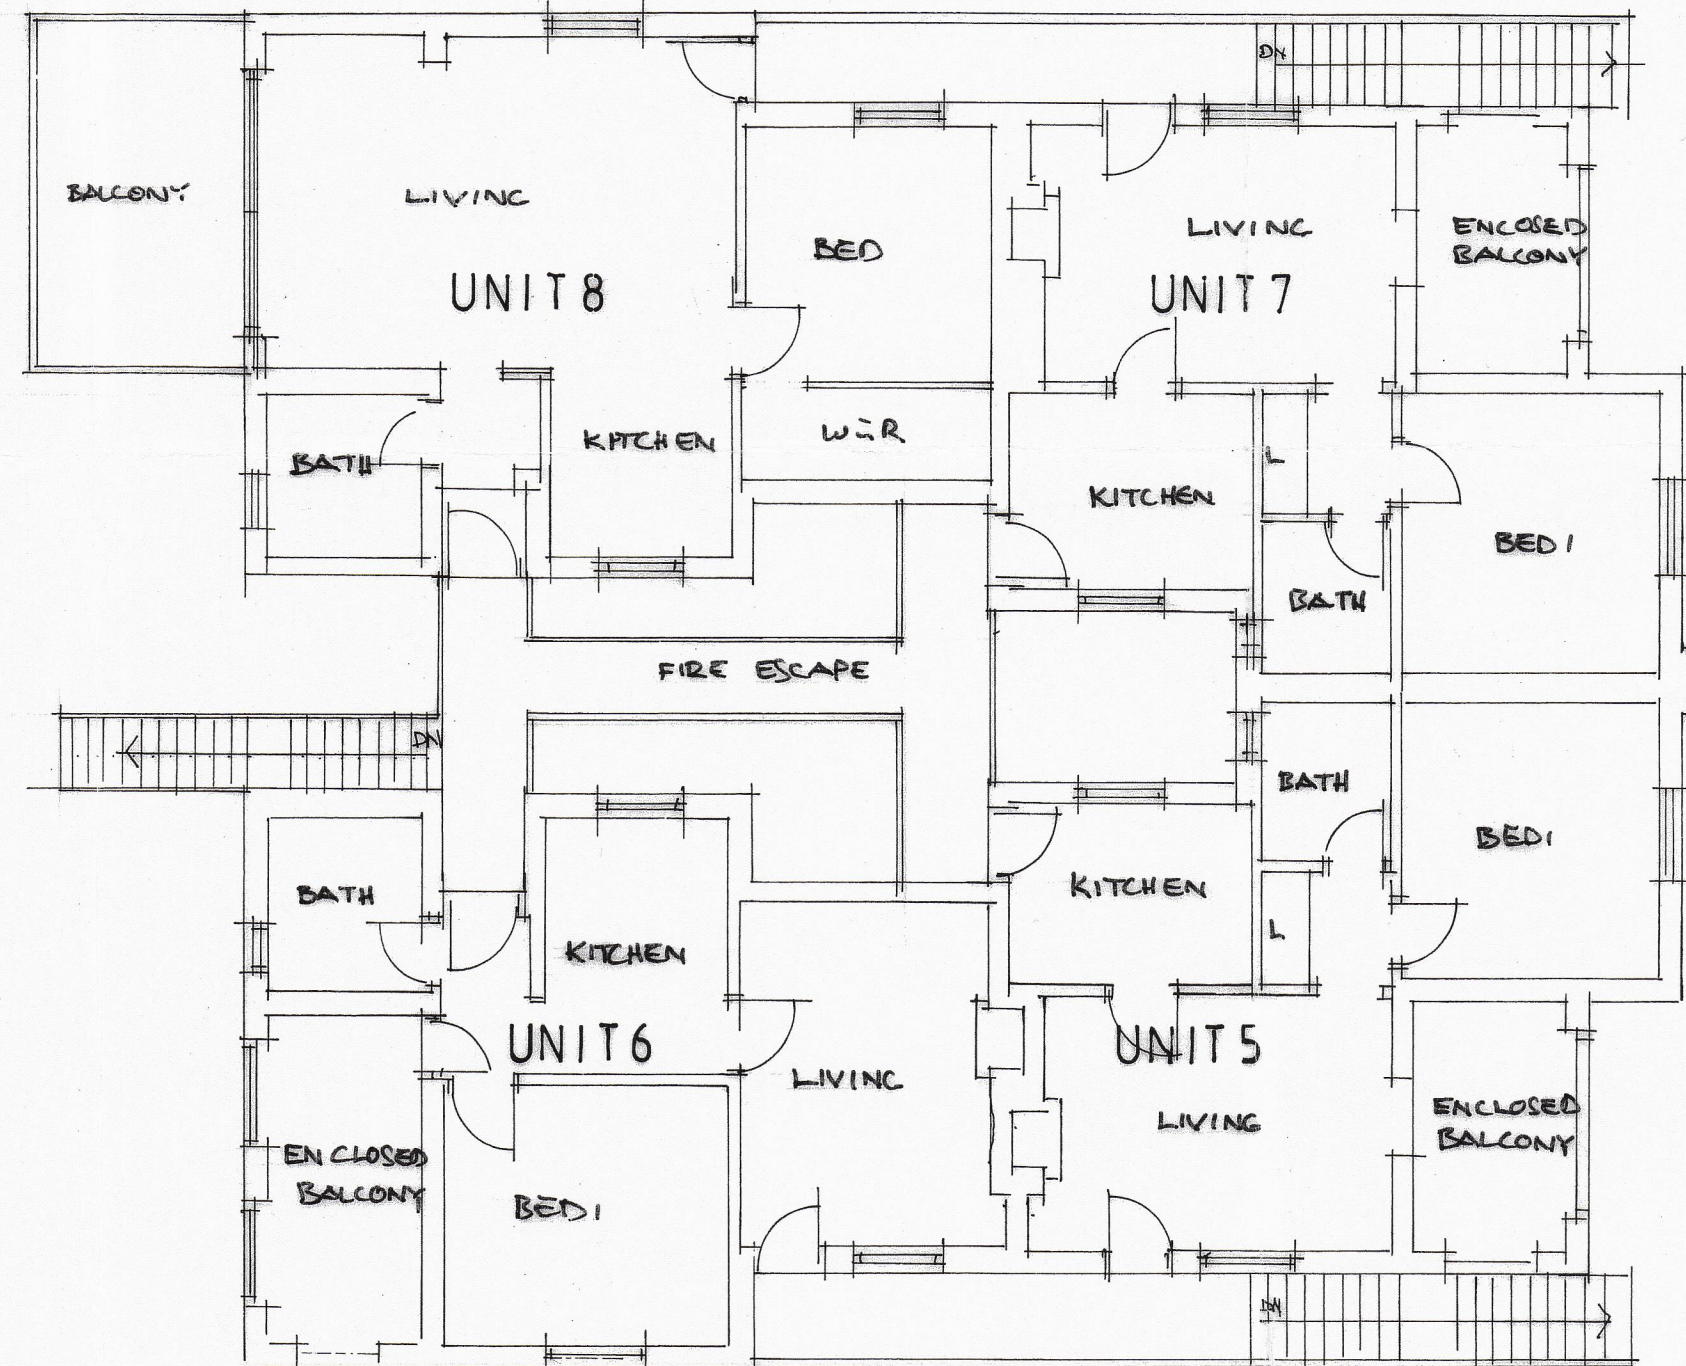

EXIST. UPPER FLOOR PLAN
SCALE 1:100

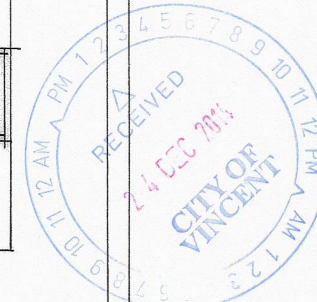

JOHN KESTEL ARCHITECT PTY. LTD.

125 BROWN ST
EAST PERTH
WA 6004
Ph: (08) 9221 3288
Fax: (08) 9221 3266
johnkestelarchitect@inet.net.au

Proposed Renovation Of Existing Multiple Dwelling units &
New Under Croft Carpark With 2 Group Dwellings Over

33 MARY STREET HIGHGATE

Existing Floor Plans of Multiple Dwelling Units


MARY STREET

A1



MARY STREET

A2

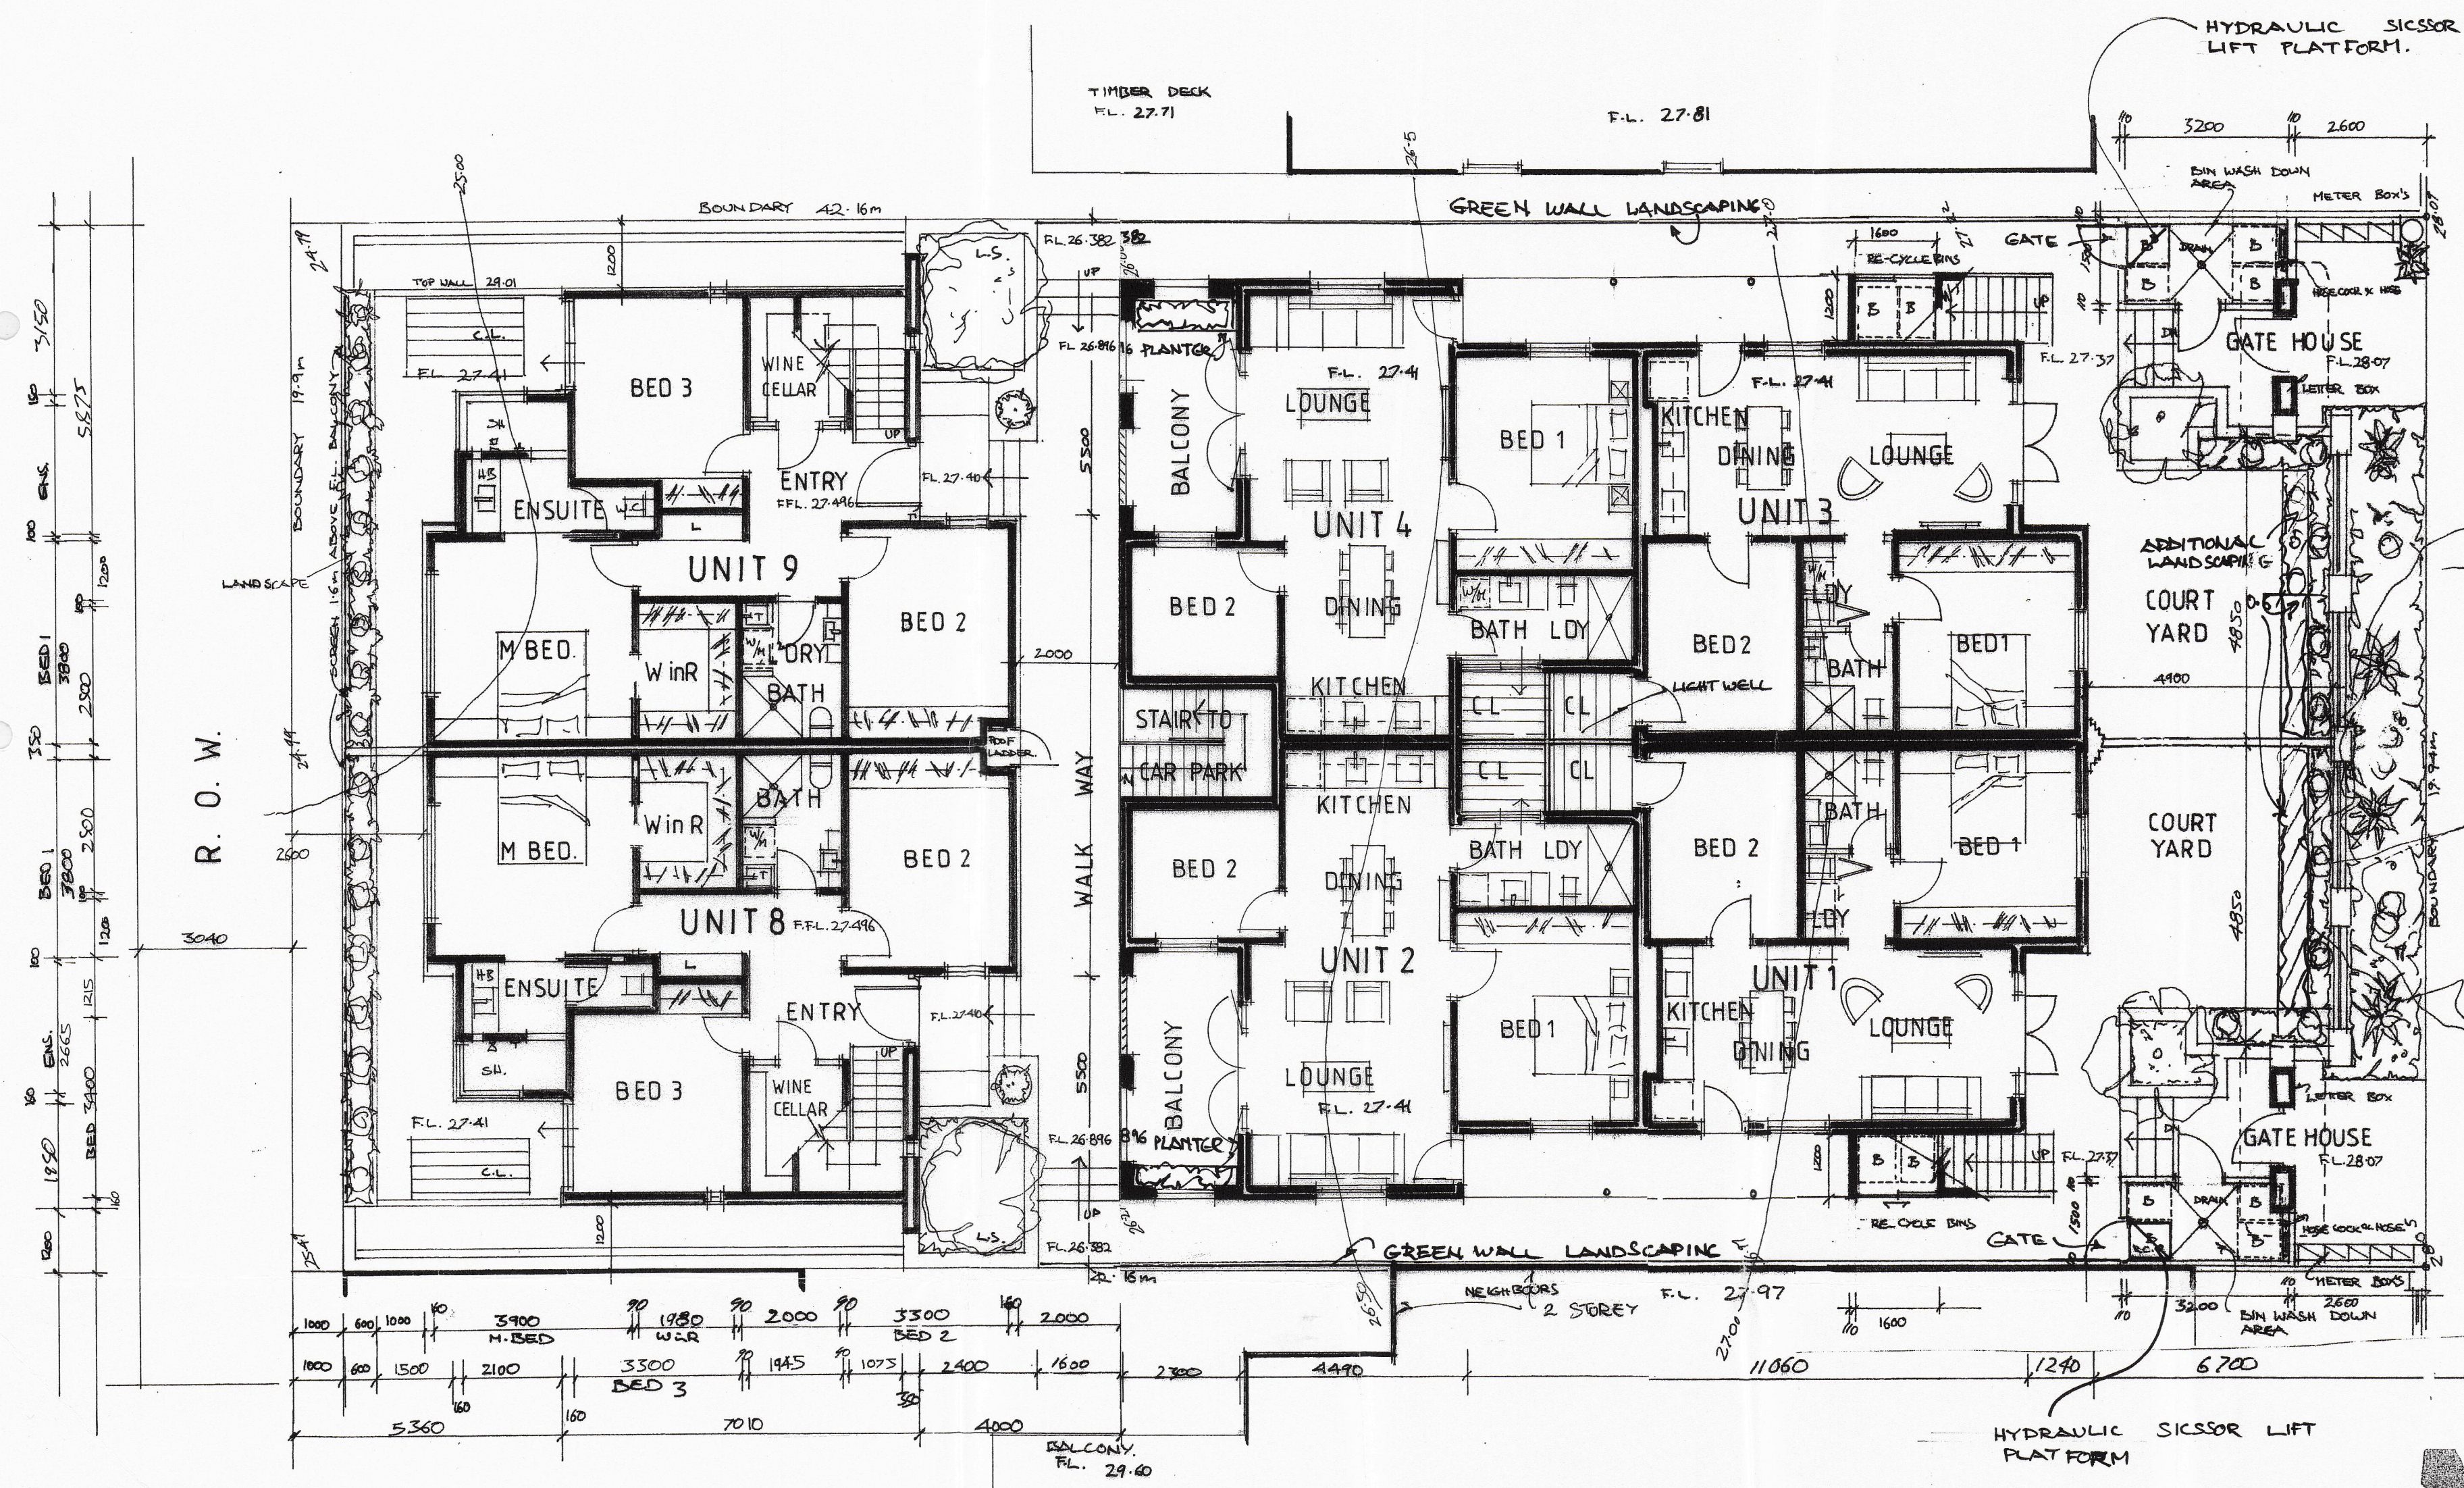

CITY OF VINCENT
 PLANNING & BUILDING SERVICES
 APPROVED/REFUSED
 IN ACCORDANCE WITH
 FORM M.R.S.3 ISSUED 21 JUL 2015
 AND AMENDMENTS SHOWN IN RED
 Manager, Planning & Building Services

RECEIVED
 02 JUN 2015
 CITY OF VINCENT

PROPOSED GROUND FLOOR PLAN SCALE 1:100


Proposed Renovation Of Existing Multiple Dwelling units &
 New Under Croft Carpark With 2 Group Dwellings Over

33 MARY STREET HIGHGATE

REVISED 3-3-15 UNIT 8, 9 & BIN AREAS
 REVISED 10-3-15 HYDRAULIC SCISSOR LIFT PLATFORM FOR
 Proposed Ground Floor Plan
 REVISED 2-04-15 ADDITIONAL
 REVISED 31-5-15 PRINTER, BALCONY LANDSCAPING.

JOHN KESTEL ARCHITECT
 PTY. LTD.
 125 Brown St
 EAST PERTH
 WA 6004
 Ph: (08) 9221 3288
 Fax: (08) 9221 3266
 Mob: 0414 470 666
 johnkestelarchitect@inet.net.au

A3

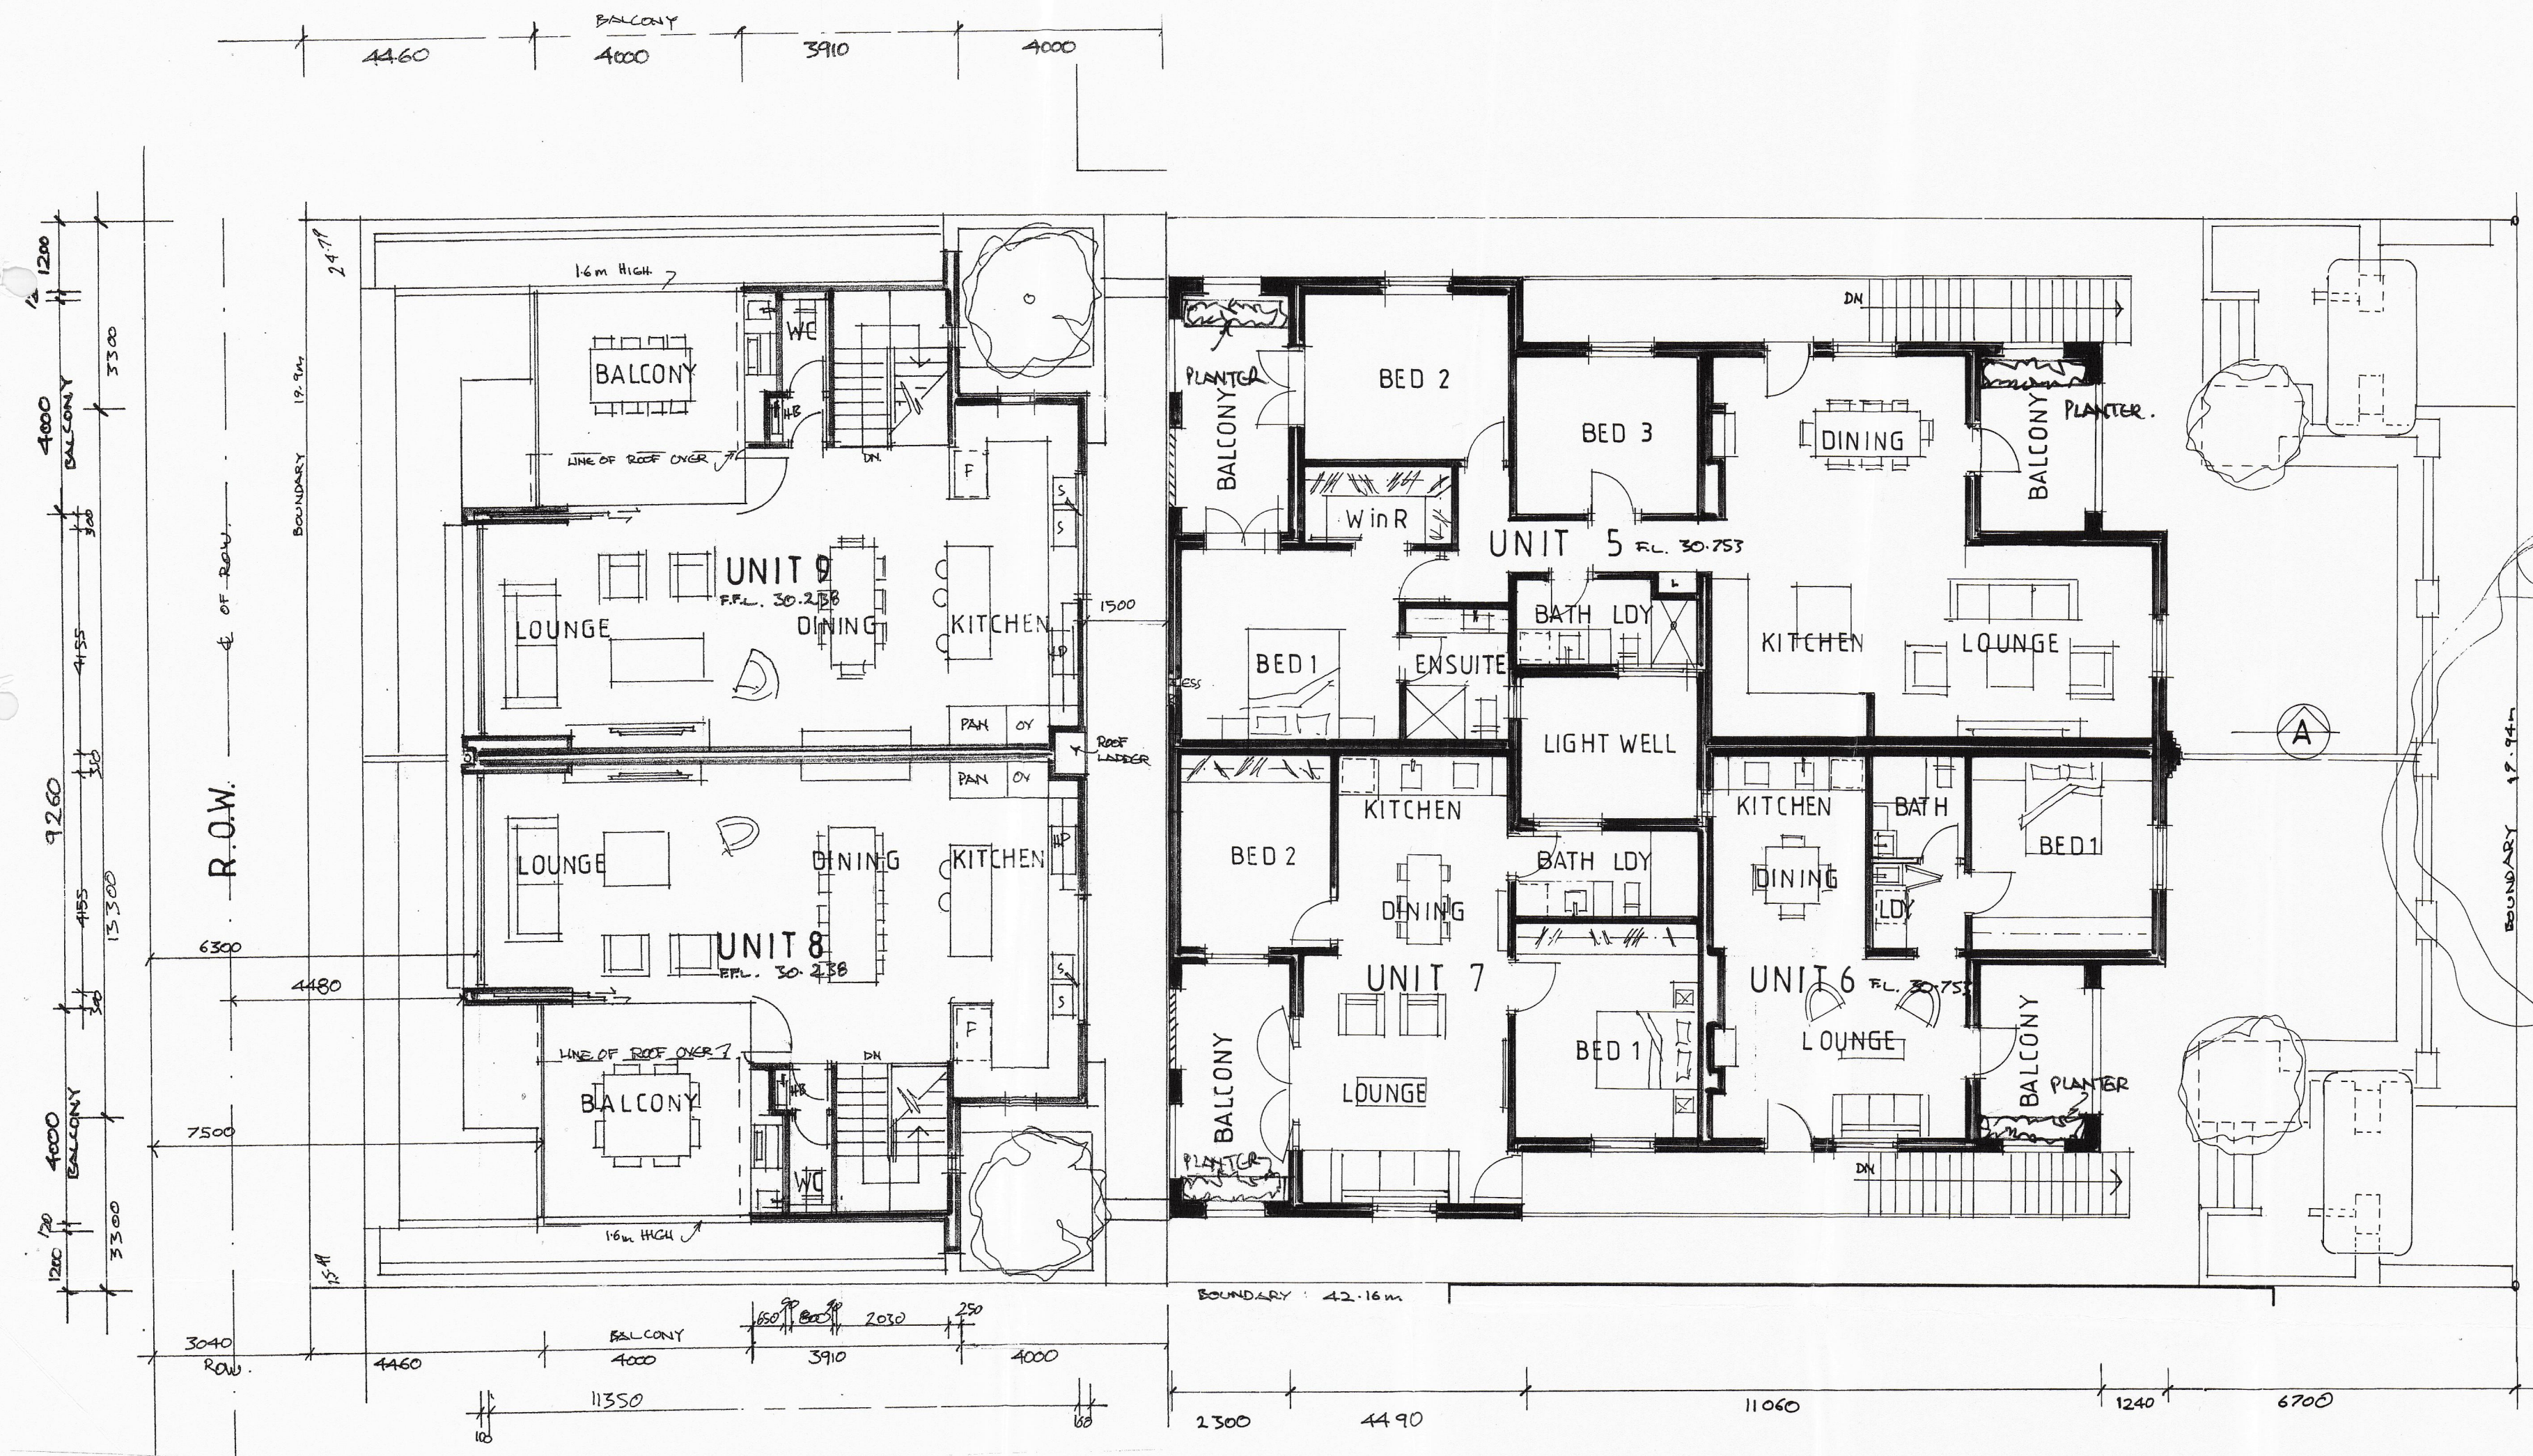

UPPER FLOOR PLAN SCALE 1:100

CITY OF VINCENT
 PLANNING & BUILDING SERVICES
 APPROVED/REFUSED
 IN ACCORDANCE WITH
 FORM M.B. 8.8 ISSUED 21 JUL 2015
 AND AMENDMENTS SHOWN IN RED
 21 JUL 2015
 Manager, Planning & Building Services

RECEIVED
 02 JUN 2015
 CITY OF VINCENT



Proposed Renovation Of Existing Multiple Dwelling Units 8
 New Under Croft Carpark With 2 Group Dwellings Over

33 MARY STREET HIGHGATE

REVISED 3-3-15 UNIT 8 & 9
 REVISED 2-4-15 OBSOURE GLASS KITCHEN WINDOW UNITS
 Proposed Upper Floor Plan
 REVISED 31-5-15 PLANTERS TO BALCONY
 + REVISED REAR UNIT LAYOUT.

JOHN KESTEL ARCHITECT PTY. LTD.
 125 Brown St
 EAST PERTH
 WA 6004
 Ph: (08) 9221 3288
 Fx: (08) 9221 3266
 Mob: 0414 470 666
 johnkestelarchitect@inet.net.au

A4

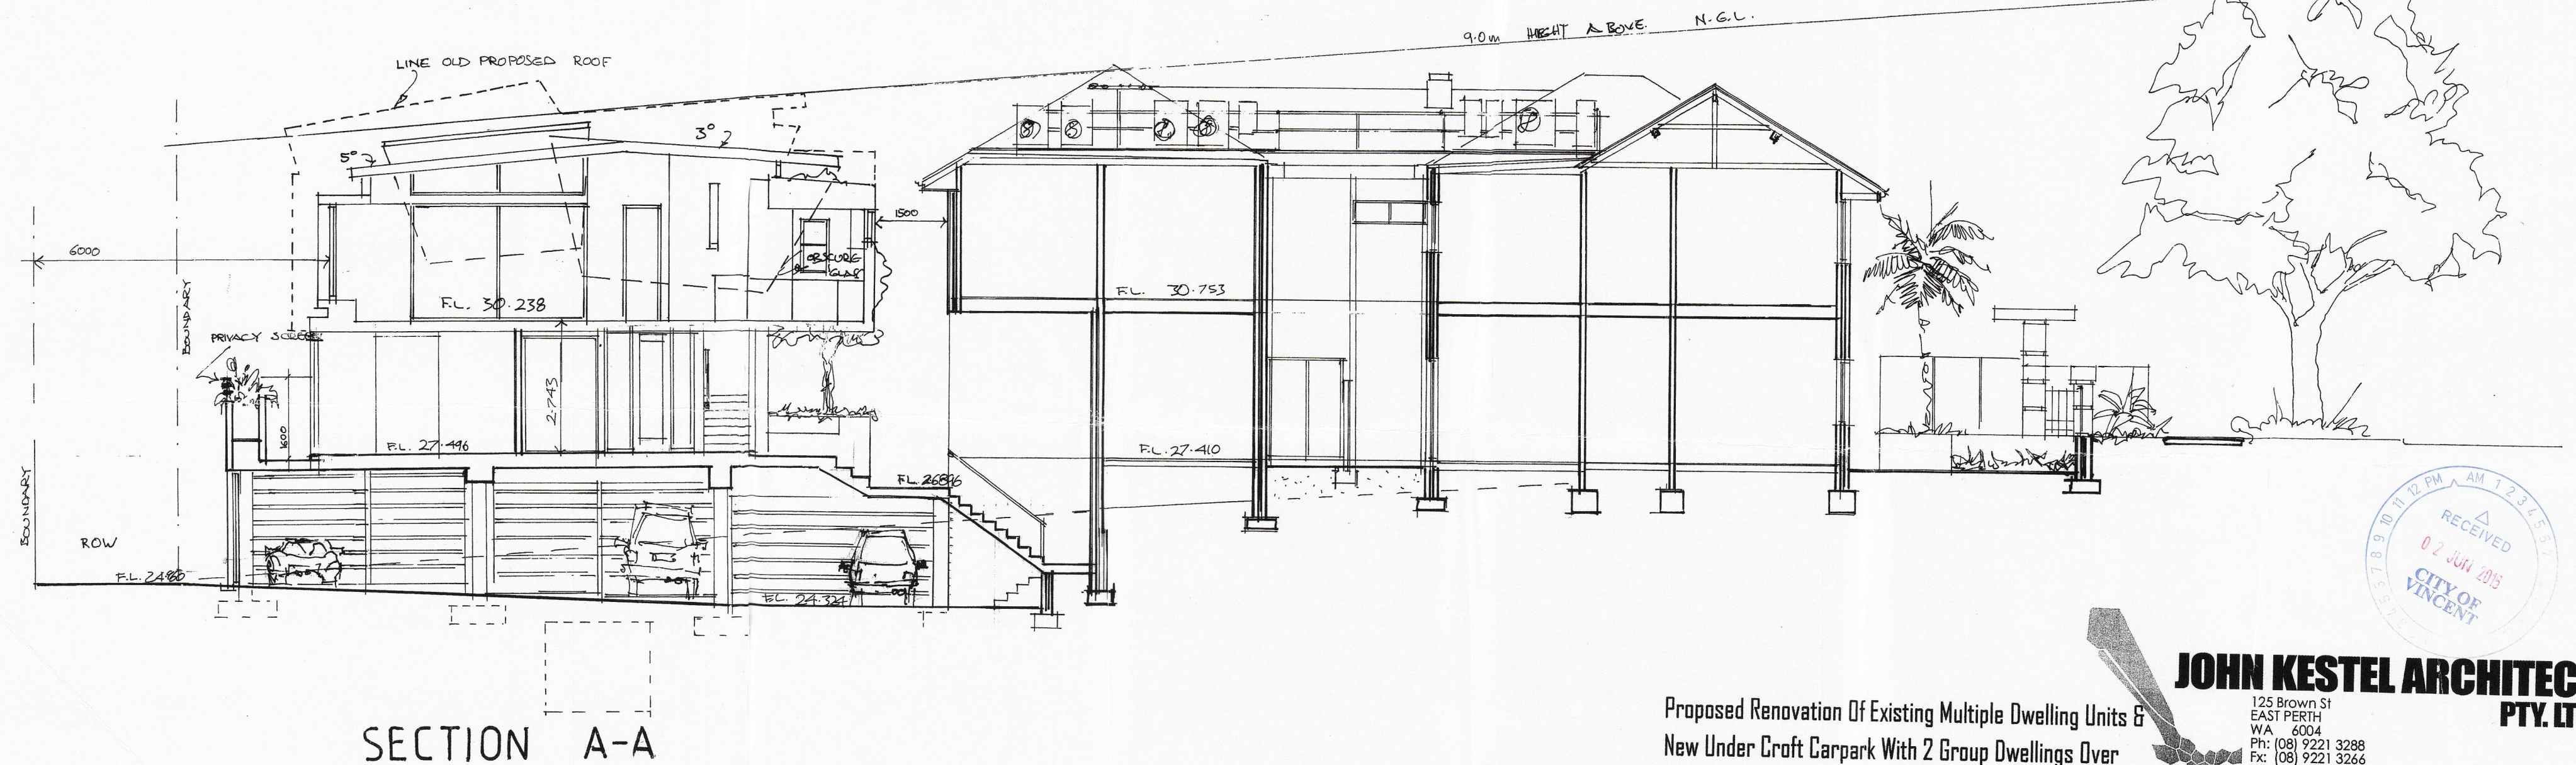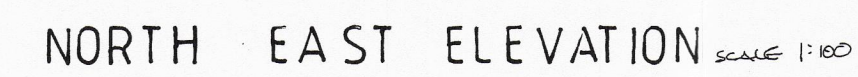

Proposed Renovation Of Existing Multiple Dwelling Units &
New Under Croft Carpark With 2 Group Dwellings Over

33 MARY STREET HIGHGATE

REVISED 3-3-15 REAR UNIT REVISED ROOF LINE REAR UNITS. 3-1-15
Proposed North East, South West Elevations & Section A-A

JOHN KESTEL ARCHITECT
125 Brown St
EAST PERTH
WA 6150
PTY. LTD.

125 Brown St
EAST PERTH
WA 6004
Ph: (08) 9221 3288
Fx: (08) 9221 3266
Mob: 0414 470 666
johnkestelarchitect@inet.net.au


A6

CITY OF VINCENT
 PLANNING & BUILDING SERVICES

~~APPROVED~~ REFUSED
 IN ACCORDANCE WITH 21 JUL 2015

FORM M.R.S.2 ISSUED..... *OMC* 30.6.15
 AND AMENDMENTS SHOWN IN RED


PP Manager, Planning & Building Services

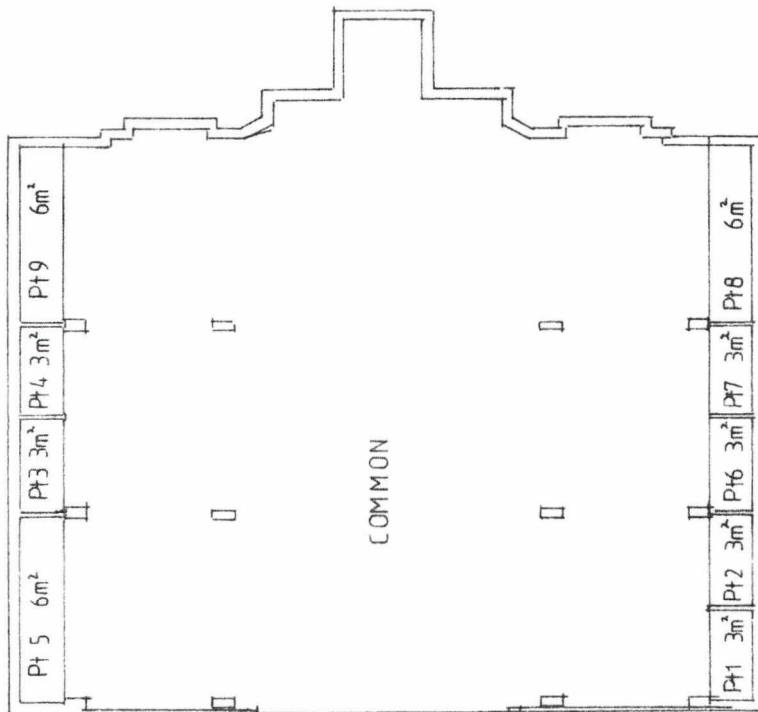

BASEMENT FLOOR PLAN scale 1:200

PROPOSED STRATA PLAN
 33 MARY STREET HIGHGATE



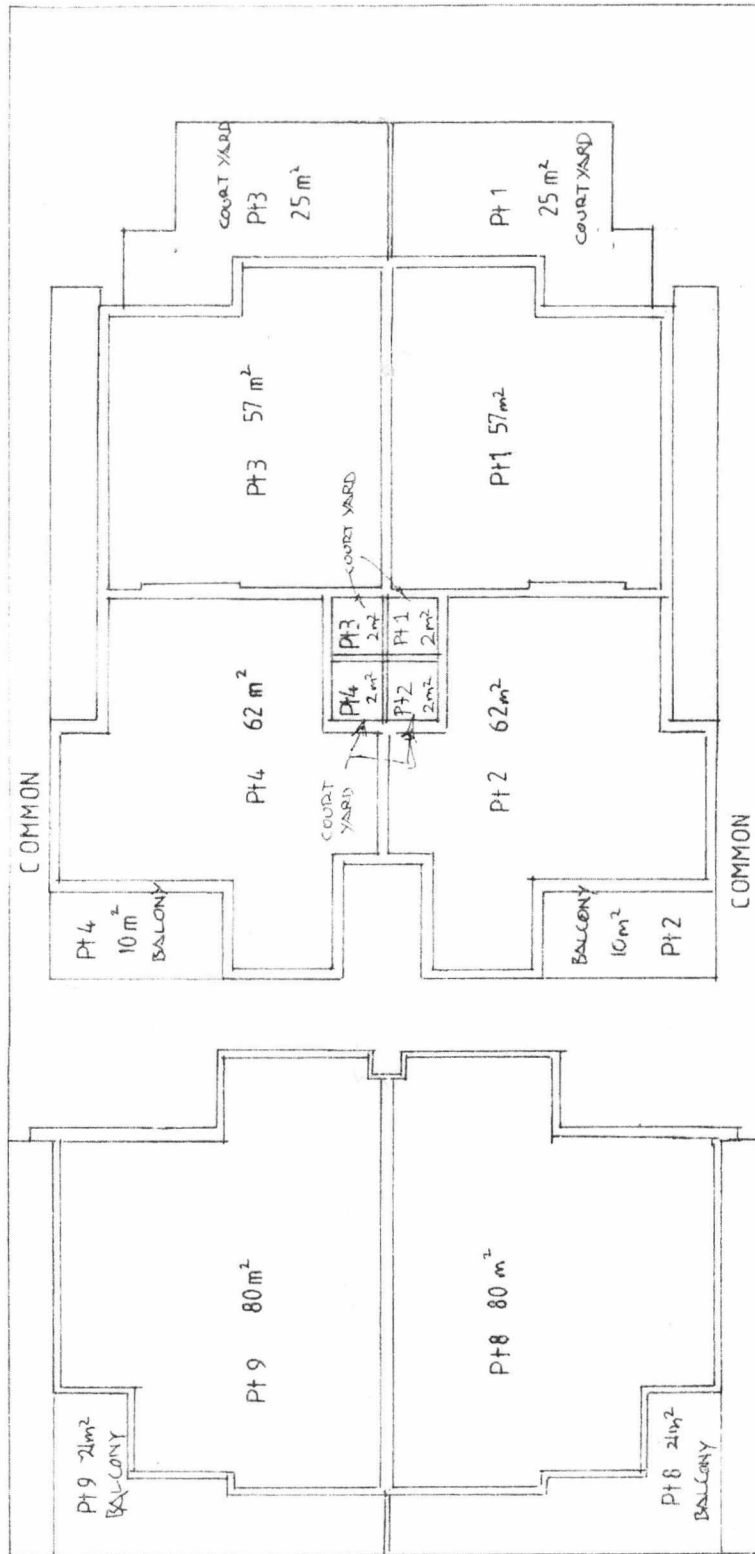

GROUND FLOOR PLAN scale 1:200

CITY OF VINCENT
 PLANNING & BUILDING SERVICES




APPROVED/REFUSED
 IN ACCORDANCE WITH

FORM M.R.S.2 ISSUED..... 21 JUL 2015
 AND AMENDMENTS SHOWN IN RED OMC 30.6.15

..... Manager, Planning & Building Services

PROPOSED STRATA PLAN
 33 MARY STREET HIGHGATE



CITY OF VINCENT
PLANNING & BUILDING SERVICES
 APPROVED/REFUSED
 IN ACCORDANCE WITH
 FORM M.R.S.2 ISSUED
 AND AMENDMENTS SHOWN IN RED
 21 JUL 2015
 CMC 30.6.15
 Manager, Planning & Building Services

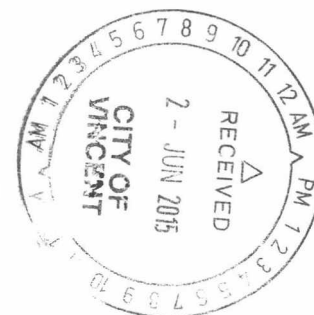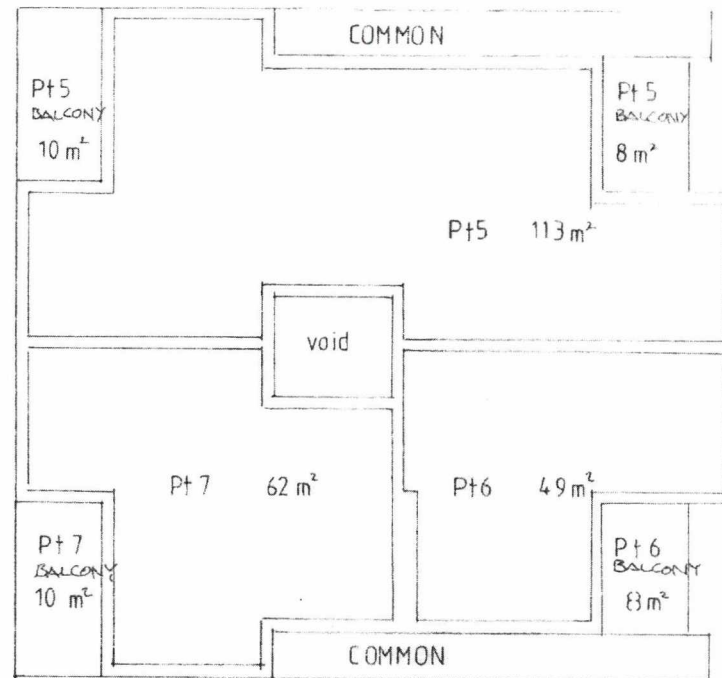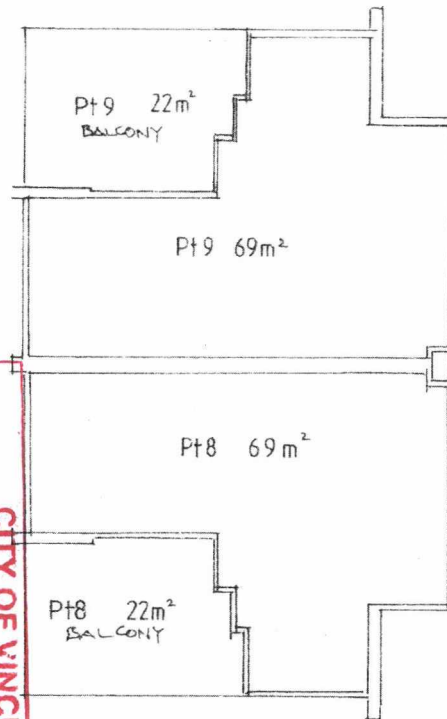


PROPOSED STRATA PLAN

FIRST FLOOR PLAN scale 1:200

33 MARY STREET HIGHGATE

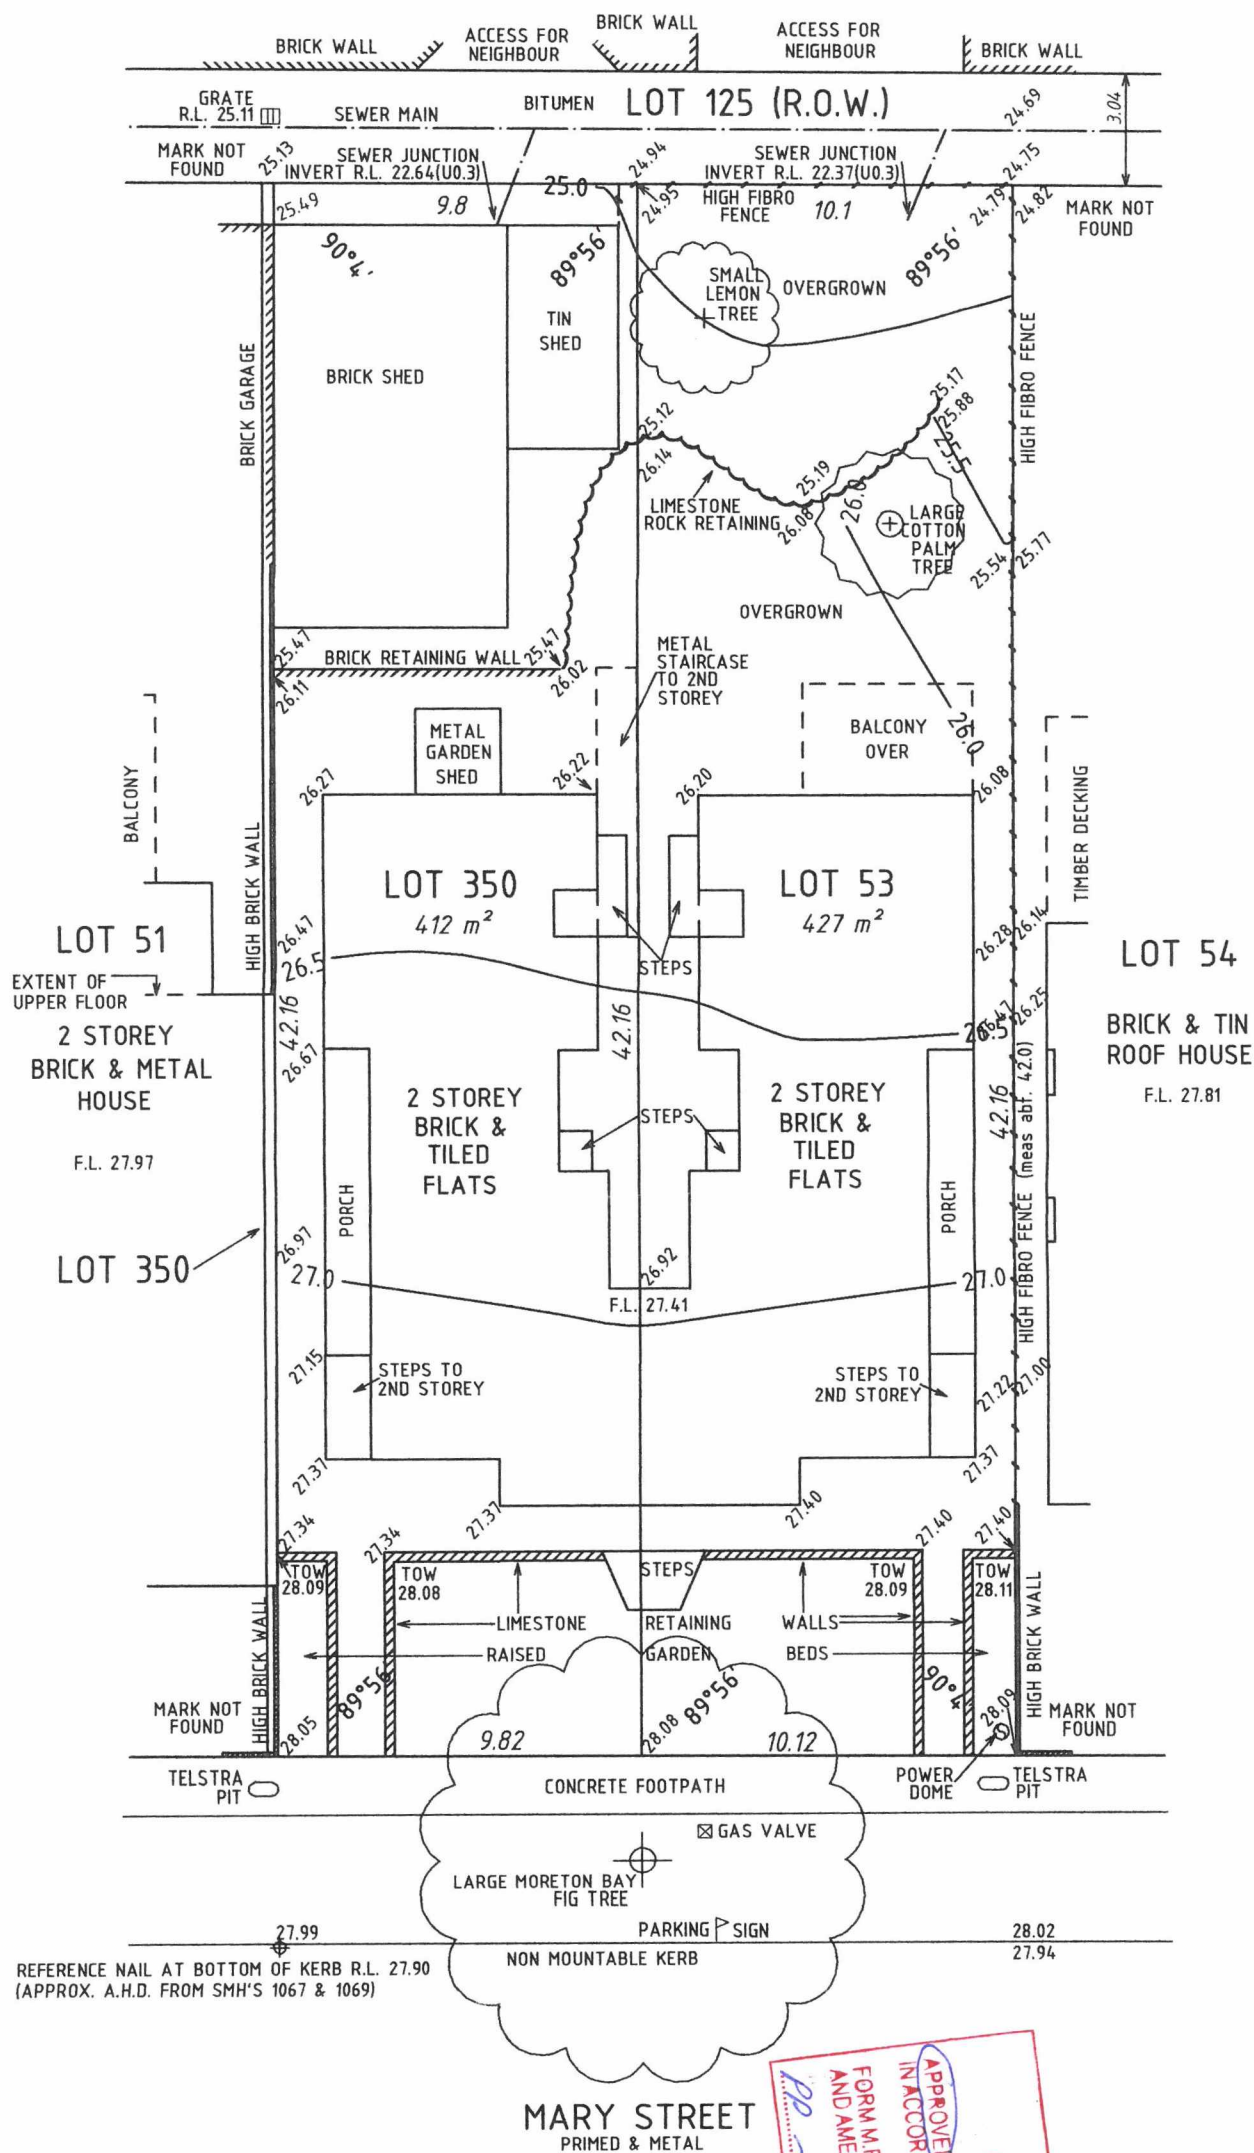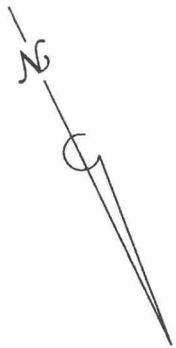

NOTE : TOW - TOP OF WALL

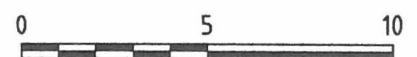

CONTOUR AND FEATURE SURVEY OF LOTS 53 & 350
35 & 33 MARY STREET, HIGHGATE

PLAN & DP : 672 & DP 302361
C/T : 1800-870
AUTHORITY : CITY OF VINCENT
TOTAL LOT AREA : 839 m²
SCALE : 1 : 200 @ A3
SURVEY DATE : 3-11-2014
JOB : 13659

DRAFTED BY : IW
DATE : 6-11-2014
CHECKED BY : MSO

CARLTON SURVEY
Licensed Surveyors
SUITE 4, 160 BURSWOOD ROAD,
BURSWOOD, W.A., 6100.
TEL 9361 5358 FAX 9361 3457
E-mail : carlton@carlton-surveys.com.au

DIAL 1100 BEFORE YOU DIG

CITY OF VINCENT
PLANNING & BUILDING SERVICES
APPROVED/REFUSED
IN ACCORDANCE WITH
FORM M.R.S. 2 ISSUED 2006
AND AMENDMENTS SHOWN IN R.L.
21 JUL 2006
30.6.15
Manager, Planning & Building Services

CHECK TITLE FOR EASEMENTS, RESTRICTIVE COVENANTS ETC.
THIS SURVEY DOES NOT GUARANTEE THE CORRECT POSITION OF BOUNDARY
PEGS OR FENCES.
ALL FEATURES AND BUILDING POSITIONS ARE APPROXIMATE ONLY, AS THEY HAVE
BEEN POSITIONED FROM MEASUREMENTS TAKEN FROM EXISTING PEGS, FENCES &
WALLS.
A BOUNDARY RE-ESTABLISHMENT SURVEY IS RECOMMENDED PRIOR TO
UNDERTAKING ANY SITE WORKS OR CONSTRUCTION.
INFORMATION SHOWN ON THIS SURVEY IS CURRENT AT THE DATE SHOWN.
CARLTON SURVEYS ACCEPTS NO RESPONSIBILITY FOR ANY CHANGES THAT
HAVE OCCURRED AFTER THIS DATE, TO SITE LEVELS AND FEATURES OR BUILDINGS.
CADASTRAL BOUNDARY DIMENSIONS SHOWN HAVE BEEN OBTAINED FROM SURVEY
PLANS AND ARE SUBJECT TO FIELD SURVEY.