
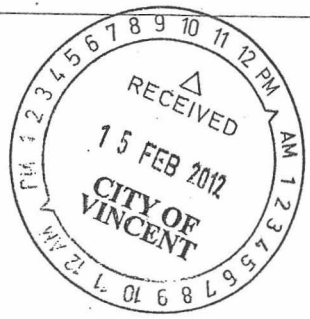
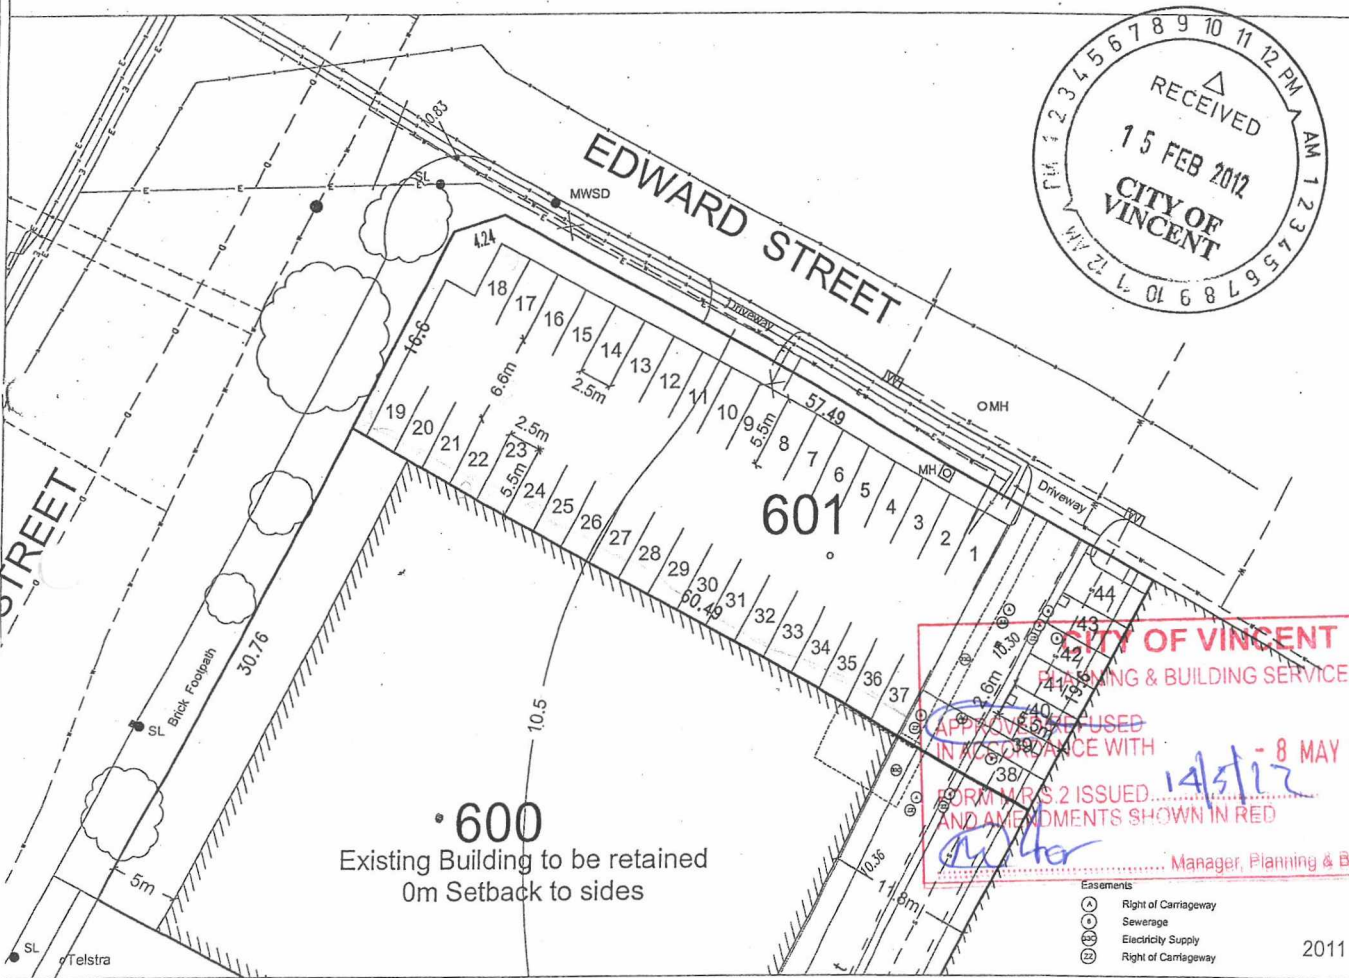


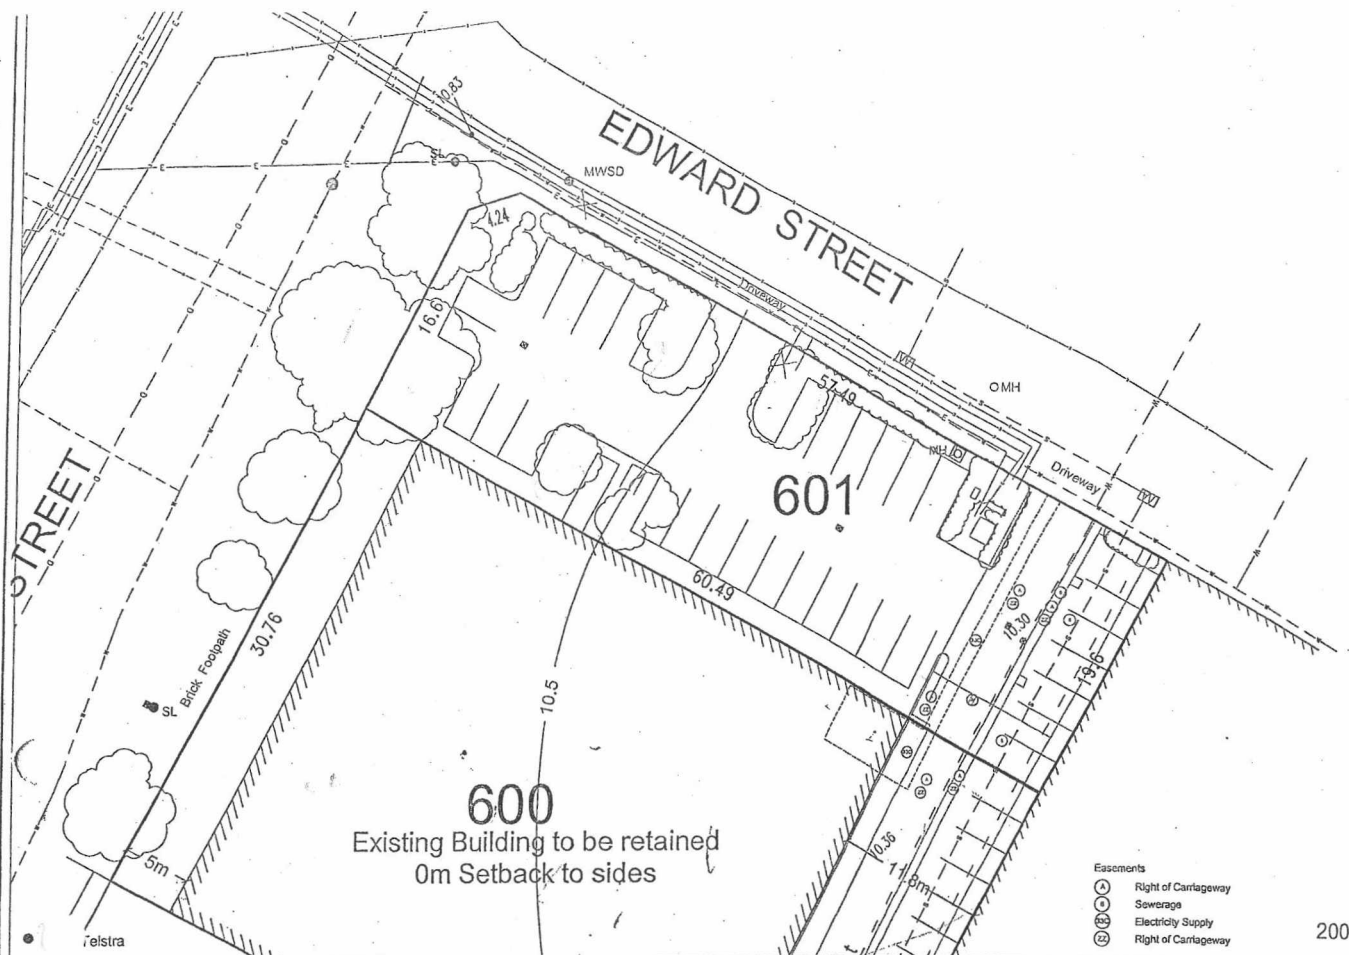

CITY OF VINCENT
 PLANNING & BUILDING SERVICES
 APPROVED FOR USE
 IN ACCORDANCE WITH
 FORM MRS 2 ISSUED 14/5/12
 AND AMENDMENTS SHOWN IN RED
 Manager, Planning & Building Services

EDWARD STREET

601

600

MWSD

MH

MH

Driveway
Strip Drain

Traversable
600mm dia
Soak Well
(150 litres)
5m² x 0.0122
= 61 litres

Easements

- A Right of Carriageway
- 6 Sewerage
- 33C Electricity Supply
- ZZ Right of Carriageway



CITY OF VINCENT
PLANNING & BUILDING SERVICES
APPROVED/REFUSED
IN ACCORDANCE WITH
FORM M.B.S.2 ISSUED 1 MAY 2012
AND AMENDMENTS SHOWN IN RED
Manager, Planning & Building Services

NOTES:

0 10 20 30 40 50m

MGA
TOWN PLANNERS
Ph: (08) 9321 3011
Fax: (08) 9324 1961
email: mgs@global.net.au

A1

Metres
Scale 1:100
Date: 20 April 2012
Ref: 2854/2854 before & after A1 LB
All dimensions and areas subject to survey

PROPOSED SITE PLAN
LOT 601, (190) STIRLING STREET
PERTH